


Index L-13 CORNER RECORD (SEARCH) Tract or _____ Cor. _____
 File No. _____ (Ref. FSM 7151.4) Survey No. _____ No. _____
 T 3N R. 38E R.D. WALLAWALLA County UNION
 Merid. WILLAMETTE N.F. UMATILLA State OREGON

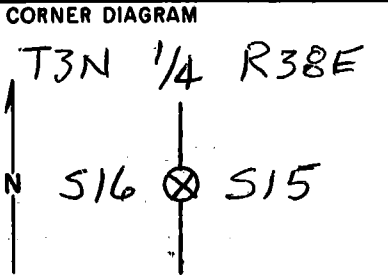

DESCRIBE CORNER MONUMENT FOUND
 ORIGINAL 7" FIR CORNER TREE IS LIVE, NOW
 24" DIAMETER WITH SINGLE HEALED BLAZES
 ON EAST & WEST SIDES, 2

DESCRIBE BEARING TREES OR OTHER OFFICIAL ACCESSORIES FOUND
 ORIG. 7" FIR IS NOW 24" LIVE FIR WITH
 DOUBLE HEALED BLAZES. BEARS EAST, 6 LINKS,
 ORIG. 8" YEW IS DEAD - SNAG, FULL SCRIBES
 VISIBLE ON DOUBLE BLAZES, BEARS N60°W, 12 LINKS,
 I PUT BEARING TREE SIGNS ON ALL 3 TREES, 3

PHOTO IDENTIFICATION DATA
 Photo No. _____
 Filed At. _____
 Object Ident. _____
 Ident. By _____
 Signature _____ 7

DESCRIBE CORNER LOCATION RELATIVE TO NEAR-BY FEATURES, ALSO HOW TO REACH CORNER
 I FIND THE BT'S FOR THE "OLD" CORNER ABOUT 300
 FEET NORTH, A 36" PONDEROSA PINE WITH BLAZES &
 CHOPPED OUT SCRIBES TO THE EAST AND A 30"
 DOUGLAS FIR WITH ~~DOUBLE~~ ^{SINGLE} HEALED BLAZE TO
 THE SOUTH WEST. CORNER IS SOUTH OF A
 LARGE COTTONWOOD STANDING NORTH OF CREEK, 4

PLANE COORDINATE POSITION DATA
 State _____ Zone _____
 X _____
 Y _____
 Estab. By _____
 Agency _____ 8

Signature Dennis J. Gaylord Title PLS Division 1636 Headquarters S.O. Date 11-12-93 FS-7100-52 (3/68) 5

CORNER RECORD (PERPETUATION)

MONUMENT: DESCRIBE NEW MONUMENT SET, OR WORK DONE TO PRESERVE EXISTING MONUMENT

ACCESSORIES : DESCRIBE NEW BT'S WITNESS OBJECTS ETC. ESTABLISHED, OR WORK DONE TO PRESERVE EXISTING EVIDENCE

Work Done By _____ Title _____ Date _____ State Registration No. _____
or Agency _____

Certified Cor. Record Prepared ? Yes No Filed At: _____ Date _____

REMARKS

Index File No. T. R. M. Tract or Surv. No. Cor.