

Index

File No.

T. 3 N.

R. 38 E.

Merid. WILLAMETTE

CORNER RECORD (SEARCH)

(Ref. FSM 7151.4)

R.D. Walla Walla

N.F. UMATILLA

Tract or

Survey No. NF Umatilla


Cor.

No. AP-482

County UMATILLA

State OREGON

CORNER DIAGRAM

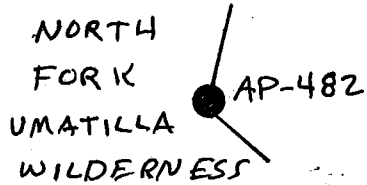

DESCRIBE CORNER MONUMENT FOUND

NONE

DESCRIBE BEARING TREES OR OTHER OFFICIAL ACCESSORIES FOUND

NONE

PHOTO IDENTIFICATION DATA

Photo No.:

Filed At.:

Object Ident.:

Ident. By:

Signature

PLANE COORDINATE POSITION

State: Oregon Zone: North

X: 2,627,191.18'

Y: 765,494.51'

Datum: NAD1927

DESCRIBE CORNER RELATIVE TO NEAR-BY FEATURES, ALSO HOW TO REACH CORNER

From the jct. of Oregon Highway 204 and 3700-070 (Umatilla Breaks Viewpoint) travel southwesterly on road 3700-070 approx. 0.3 miles to the Umatilla Breaks Viewpoint. From this point descend S. 75 W., approx. 340 feet following along the top of a spur ridge to the corner.

Signature

D. Schlaich

Title

Land Surveyor

Division

Headquarters

S.O.

Date

06/1996

FS-7100-52 (3/68)

CORNER RECORD (PERPETUATION)

MONUMENT: DESCRIBE NEW MONUMENT SET, OR WORK DONE TO PRESERVE EXISTING MONUMENT

Set on a spur ridge at an elevation of 5000 feet a 5/8" by 24" rebar, with a 3 1/4" aluminum cap, 10" in the ground, mkd. "NFU WILDERNESS AP-482 RLS 2308 1996"

ACCESSORIES : DESCRIBE NEW BT's WITNESS OBJECTS ETC. ESTABLISHED, OR WORK DONE TO PRESERVE EXISTING EVIDENCE

7" White Fir, N 57 1/2° E, 72.1 feet, mkd. "WB/482" "BT".
5" Ponderosa Pine, S 63 1/2° E, 155.7 feet, mkd. "WB/482" "BT".

BT's are double blazed and have a 3/4" brass washer mkd. "RLS 2308" nailed to the lower blaze by the "BT" scribing.

Work Done By D. Schlaich	Title Land Surveyor	Date 06/1996	State Registration No. or Agency
Certified Cor. Record Prepared ? NO	Filed At:		Date

REMARKS

Index File No.	T.	R.	M.	Tract or Survey No.	Cor.
	3 N.	38 E.	W.M.	NF Umatilla	AP-482