

USDA-FOREST SERVICE

Index
 File No. T. 3 N. R. 38 E. Merid. WILLAMETTE

CORNER RECORD (SEARCH)
 (Ref. FSM 7151.4)


Tract or
 Survey No. **NF UMATILLA**

Cor.
 No. **AP-425**

R.D. WALLA-WALLA
 N.F. UMATILLA

County **UMATILLA**
 State **OREGON**

CORNER DIAGRAM

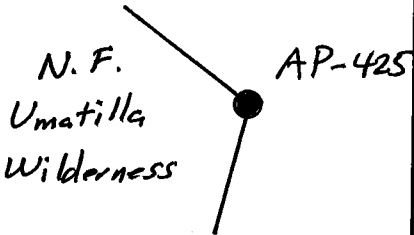

DESCRIBE CORNER MONUMENT FOUND

NONE

DESCRIBE BEARING TREES OR OTHER OFFICIAL ACCESSORIES FOUND

NONE

PHOTO IDENTIFICATION DATA

Photo No.:
 Filed At:
 Object Ident.:
 Ident. By:

Signature

DESCRIBE CORNER RELATIVE TO NEAR-BY FEATURES, ALSO HOW TO REACH CORNER

The corner is located in a small draw at an elevation of 5000 feet.

PLANE COORDINATE POSITION

State: OREGON Zone: NORTH
 X: 2,689,189.476 meters
 Y: 234,617.538 meters
 Datum: NAD83(1991)

Signature
D. Schlaich

Title
Land Surveyor

Division

Headquarters
S.O.

Date
09/1994

FS-7100-52 (3/68)

CORNER RECORD (PERPETUATION)

MONUMENT: DESCRIBE NEW MONUMENT SET, OR WORK DONE TO PRESERVE EXISTING MONUMENT

Set a 5/8" by 24" rebar, with a 3 1/4" aluminum cap, flush with the ground, mkd. "NFU WILDERNESS AP-425 ELEV 5000 RLS 2308 1994"

ACCESSORIES : DESCRIBE NEW BT's WITNESS OBJECTS ETC. ESTABLISHED, OR WORK DONE TO PRESERVE EXISTING EVIDENCE

Steel Fence Post, with Wilderness Boundary & Land Survey Monument signs attached, N. 46° W., 1.5 feet.

Work Done By **D. Schlaich**

Title **Land Surveyor**

Date **09/1994**

State Registration No.
or Agency

Certified Cor. Record Prepared ? **NO**

Filed At:

Date

REMARKS

Index File No.

T.

3 N.

R.

38 E.

M.

W.M.

Tract or Survey No.

NF UMATILLA

Cor.

AP-425