

Index
File No. Z-1

CORNER RECORD (SEARCH)


(Ref. FSM 7151.4)

Tract or
Survey No. _____ Cor.
No. Z-1

T 3S R. 30E R.D. UKiah County _____

Merid. _____ N.F. _____ State _____

CORNER DIAGRAM

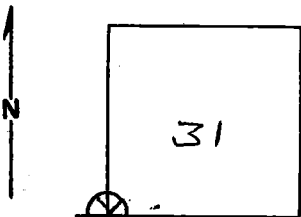

DESCRIBE CORNER MONUMENT FOUND

Stone. Call Size. Call notches. (according to notches
Stone has probably been turned 90° counterclockwise.)
In stone mound, 50 ft. above ground break, near
center top edge of slump scarp. (Talus slide below)
Stone sets solid on end in mound, probably original.

DESCRIBE BEARING TREES OR OTHER OFFICIAL ACCESSORIES FOUND

No original B.T.'s

PHOTO IDENTIFICATION DATA

Photo No. _____
Filed At. _____
Object Ident. _____
Ident. By _____
Signature

DESCRIBE CORNER LOCATION RELATIVE TO NEAR-BY FEATURES, ALSO HOW TO REACH CORNER.

I placed a location poster on an old pine stump
20 ft. east of road. The stone can be seen
silhouetted on the horizon, bearing N 68° E
from the poster, approx. 200 ft. distance.
Road passes thru a small thru cut about
200 ft. north of poster.

PLANE COORDINATE POSITION DATA

State _____ Zone _____
X _____
Y _____
Estab. By _____
Agency

Signature
T. Hollaman

Title

Division

Headquarters

Date
4-18-80

7100-52-(3/68)

CORNER RECORD (PERPETUATION)

MONUMENT: DESCRIBE NEW MONUMENT SET, OR WORK DONE TO PRESERVE EXISTING MONUMENT

ACCESSORIES : DESCRIBE NEW BT's WITNESS OBJECTS ETC. ESTABLISHED, OR WORK DONE TO PRESERVE EXISTING EVIDENCE

Work Done By _____ **Title** _____ **Date** _____ **State Registration No. or Agency** _____

Certified Cor. Record Prepared ? Yes No **Filed At:** _____ **Date** _____

REMARKS

Index File No. _____ **T.** _____ **R.** _____ **M.** _____ **Tract or Surv. No.** _____ **Cor.** _____