

OREGON CORNER RESTORATION FORM

Section 32 Township 3S Range 29E
 County Umatilla Date: 7-Apr-22

Corner Designation: 3S29Z7

X Condition report only
 Not Found
 Remonumented
 Unrecorded
 Surveyed In
 Referenced Out



South quarter corner to Section 32 only, T3S, R29E, W.M.,
 Umatilla County, Oregon.

Previous Renewals, Surveys, etc...

This corner was originally set by George Pershin under Contract No. 332, Dated July 29th, 1879. His record reads: Set basalt stone 16x8x5 on W. face of spur for 1/4 Sec. Cor.

Monument and accessories found: (condition and source)

Found a basalt stone 16x7x4 plainly marked 1/4 firmly set but leaning downhill to the west in the remains of a stone mound.

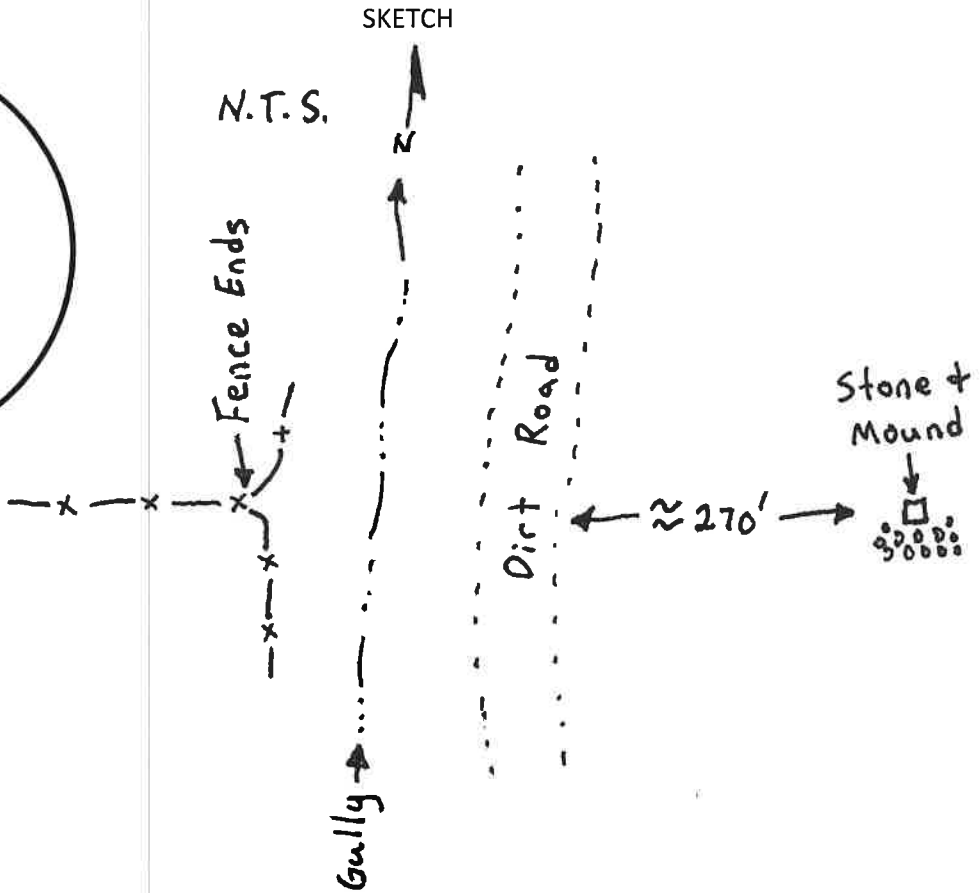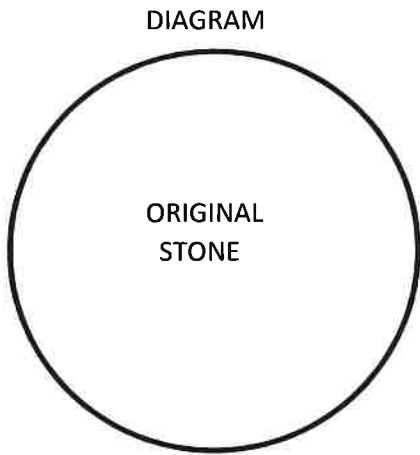

MONUMENT(S) AND ACCESSORIES SET (Procedures and Description)

At the corner point I dig and reset the original stone 12 inches in the ground in a vertical position with the marks "1/4" on the north face as when found. I rebuilt the mound of stone 3' diameter and 1.5' high along the south side of the stone. The work was witnessed by Mr. Charles Doherty, 1214 NW King Avenue, Pendleton, OR 97801.

Measurements were made with a Trimble R8S base/rover RTK GPS system.

Location and comments:

Approximate coordinate SP NAD83
 Northing = 582126.7'
 Easting = 8558688.9'


RECEIVED BY:

Umatilla County Surveyor
 Date: 8/1/22
 Rec'd By: CT
 No. 22-083-C


Compass Declination

Firm / Agency
 Witness Tree Surveying
 Address
 P.O. Box G
 Pilot Rock, OR 97868
 Party Chief
 Stephen K. Haddock

Surveyor's Seal

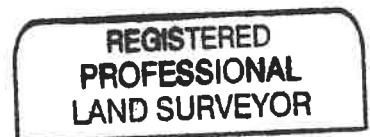

Stephen K. Haddock

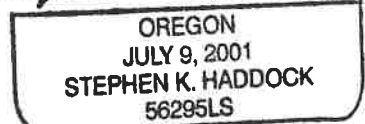

RENEWS: 6-30-23