


CERTIFIED RECORD OF LAND CORNER MONUMENTATION

L - 25
DIAGRAM

History of original corner establishment:

The original corner was established by George Williams on September 28, 1872, under GLO contract No. 176, as follows:

Set a stone, 20" x 9" x 5", on west slope of high hill for 1/4 section corner.

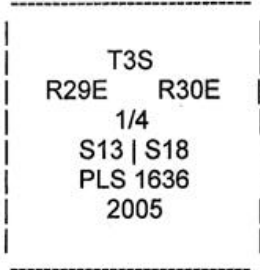

Original corner evidence recovered:

Found the original corner stone solidly set 10" in the ground in a mound of stones. The corner stone is 17" x 10" x 6" and is plainly marked "1/4" on the east face.

Monument and accessories established to perpetuate the original position of this corner:

In place of the original corner stone, I set a 1" x 18" flared, galvanized iron pipe 15" into the ground to bedrock. A 2 1/2" brass cap attached to the top of the pipe is marked as shown in the diagram above. I bury the corner stone along the north side of the pipe and build a mound of stones around the pipe, from which:

A 5/8" x 24" iron rod set 23" into the ground, with a 3/4" brass washer, marked "PLS 1636 NE", attached at ground level, bears N33° E, 104.6 feet.


A 5/8" x 24" iron rod set 23" into the ground, with a 3/4" brass washer, marked "PLS 1636 SE", attached at ground level, bears S52° E, 81.0 feet.

A 5/8" x 24" iron rod set 23" into the ground, with a 3/4" brass washer, marked "PLS 1636 SW", attached at ground level, bears S12° 30' W, 68.1 feet.

A 5/8" x 24" iron rod set 23" into the ground, with a 3/4" brass washer, marked "PLS 1636 NW", attached at ground level, bears N48° W, 122.0 feet.

This corner marks a point on the Morrow - Umatilla County line.

I hereby certify the above corner point was perpetuated as hereon described on February 8, 2005. Magnetic declination set in compass: 16° E.
NAD '83 UTM Zone 11 position: 5019239N, 331738E (plus or minus two meters).

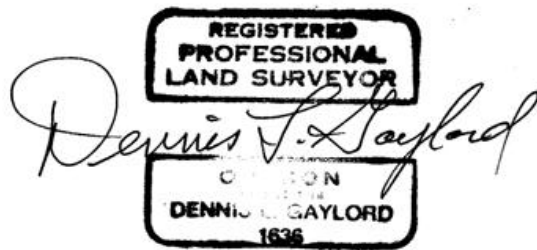

Renews June 30, 2005

Recorded at the office of County Surveyor, County of Morrow, State of Oregon, on:

RECEIVED BY
 Umatilla County Surveyor
 Date 2-05
 Rec'd By KK
 No. 02-28-R