


CERTIFIED RECORD OF LAND CORNER MONUMENTATION

L - 21
DIAGRAM

History of original corner establishment:

The original corner was established by George S. Pershin on September 8, 1879, under GLO contract No. 332, as follows:

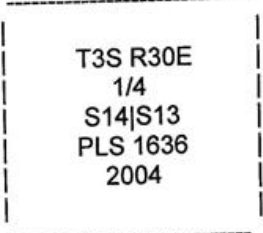

Set a basalt stone, 16" x 14" x 5", on north slope for the 1/4 section corner to sections 13 and 14.

Original corner evidence recovered:


Found the original corner stone loosely set in a mound of stones. The corner stone is 16" x 16" x 7" and is plainly marked "1/4" on one face.

Monument and accessories established to perpetuate the original position of this corner:

In place of the original corner stone, I set a 1" x 30" flared, galvanized iron pipe 27" into the ground. A 2 1/2" brass cap attached to the top of the pipe is marked as shown in the diagram above. I bury the corner stone along the north side of the pipe and build a small mound of stones around the pipe, from which:

- A 5/8" x 24" iron rod set 23" into the ground, with a 3/4" brass washer, marked "PLS 1636 NE", attached at ground level, bears N47° 30' E, 140.1 feet.
 - A 5/8" x 24" iron rod set 23" into the ground, with a 3/4" brass washer, marked "PLS 1636 SE", attached at ground level, bears S36° 30' E, 113.7 feet.
 - A 5/8" x 24" iron rod set 23" into the ground, with a 3/4" brass washer, marked "PLS 1636 SW", attached at ground level, bears S50° 30' W, 145.6 feet.
 - A 5/8" x 24" iron rod set 23" into the ground, with a 3/4" brass washer, marked "PLS 1636 NW", attached at ground level, bears N18° 30' W, 139.2 feet.
- I nail a "Witness Post" sign to a fence corner post, with fences projecting east, west and south, 0.5 feet south of the corner.

I hereby certify the above corner point was perpetuated as hereon described on April 30, 2004. Magnetic declination set in compass: 18° E.
NAD '83 UTM Zone 11 position: 5018909N, 339876E (plus or minus two meters).

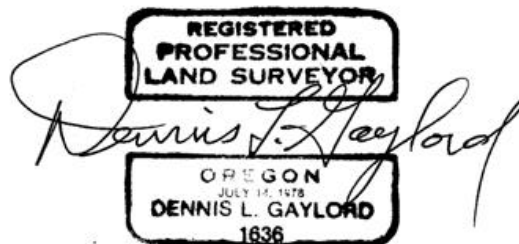

Renews June 30, 2005

Recorded at the office of County Surveyor, County of Morrow, State of Oregon, on:

RECEIVED BY
Umatilla County Surveyor,
Date 5-04
Rec'd By KK
No. 04-91-R