

CERTIFIED RECORD OF LAND CORNER MONUMENTATION

J - 25  
DIAGRAM

History of original corner establishment:

The original corner was established on October 29, 1878, by George S. Pershin under GLO contract No. 304, as follows:

Set a stone, 22" x 18" x 8", on east side near bottom of ravine for the corner to sections 12 and 13, from which:

- A 12" Balm bears S40° W, 16 links (10.56 feet).
- A 11" Balm bears N85° W, 43 links (28.38 feet).

Original corner evidence recovered:

Found the original corner stone solidly set in a mound of stones. The corner stone is 18" x 17" x 10" and is plainly marked with 2 notches on the north edge, from which:


- A 30" down Cottonwood with a nearly healed upper blaze with decayed face, and a healed lower blaze. Root hole bears S40° W, 10.6 feet.
- The record bearing tree to the northwest is gone.

Monument and accessories established to perpetuate the original position of this corner:

In place of the original corner stone, I set a 1" x 30" flared, galvanized iron pipe 24" into the ground. A 2 1/2" brass cap attached to the pipe is marked as shown in the diagram above. I bury the corner stone to the northeast side of the pipe and build a mound of stones around the pipe, from which:

- A 5/8" x 24" iron rod set 23" into the ground with a 3/4" brass washer, marked "PLS 1636 11", attached at ground level, bears N68° E, 26.9 feet.
- A 5/8" x 24" iron rod set 23" into the ground with a 3/4" brass washer, marked "PLS 1636 14", attached at ground level, bears S13° 30'E, 18.4 feet.
- A 5/8" x 24" iron rod set 23" into the ground with a 3/4" brass washer, marked "PLS 1636 13", attached at ground level, bears S34° W, 26.0 feet. This reference is about 15 feet northeast of Alexander Creek.
- A 5/8" x 24" iron rod set 23" into the ground with a 3/4" brass washer, marked "PLS 1636 12", attached at ground level, bears N47° 30'W, 39.2 feet.

I hereby certify the above corner point was perpetuated as hereon described on May 23, 2003. Magnetic declination set in compass: 17°E. NAD '83 UTM Zone 11 position: 5019665N 341537E (plus or minus two meters).

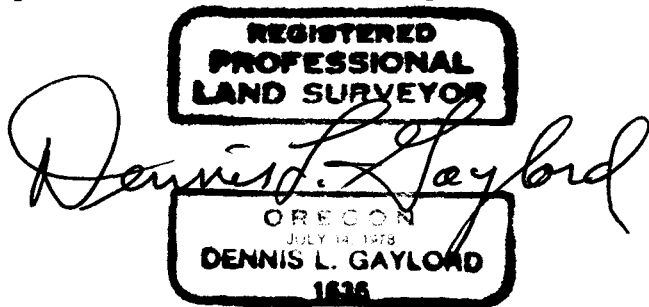

Renews June 30, 2003

Recorded at the office of County Surveyor, County of Umatilla, State of Oregon, on:

RECEIVED BY  
 Umatilla County Surveyor  
 Date 9-03  
 Rec'd By KK  
 No. 03-261-R