


History of original corner establishment:

Original corner established by George S. Pershin on May 5, 1879, under contract number 319, as follows:


Set a basalt stone, 18" x 12" x 5", on the south side of mountain near top. Set a stake and raised a mound of stones around the stone and stake in lieu of pits.

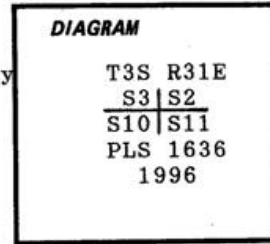

Description of corner evidence found:

The original corner stone is solidly set in a mound of stones. The corner stone is 20" x 13" x 10" and is plainly marked with 2 notches on the east edge and one notch on the north edge. The post is gone.

Description of monument and accessories established to perpetuate the original location of this corner:

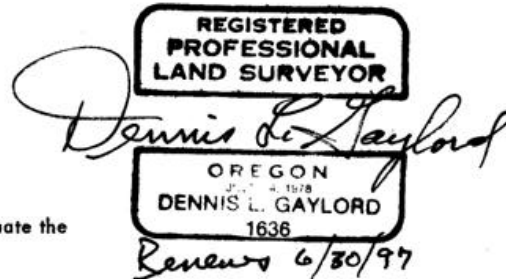

In place of the stone, I set a 1 1/2" x 30" galvanized iron pipe with a 2 1/2" brass cap attach, 20" into the ground. The brass cap is marked as shown in the diagram above. I bury the corner stone along the east side of the pipe and build a mound of stones around the pipe to the cap. From which:

A basalt outcrop, 5' high by 10' wide, is chiseled "+ 2" on an overhung face 18" above the base of the outcrop. The "+" bears N16°E, 10.5 feet.

A 3/4" x 36" aluminum rod set 18" into the ground and surrounded by a mound of stones bears S37°E, 42.3 feet. A 5/8" brass washer wired to the rod at ground level is marked "PLS 1636 S11".

A 3/4" x 14" aluminum rod set 14" into the ground and surrounded by a mound of stones bears S47°W, 43.0 feet. A 5/8" brass washer wired to the rod is marked "PLS 1636 S10".

A basalt outcrop, 10' high by 40' wide, is chiseled "+ 3" on a smooth face 4 feet above the base of the outcrop. The "+" bears N75°W, 39.5 feet.

I hereby certify the above corner point was perpetuated as hereon described on October 14, 1996. Magnetic declination: 19°E.

Office of COUNTY SURVEYOR County of UMATILLA  
 State of OREGON, I hereby certify that the within instrument was filed in this office  
 for record on the ..... day of ..... , 19.....  
 ..... by .....  
 (COUNTY OFFICIAL) (DEPUTY)

E-17

RECEIVED BY

Umatilla County Surveyor  
 Date 10-96  
 Rec'd by KK  
 No. 96-166-R