


History of original corner establishment:


Original corner set by George S. Pershin on May 2, 1879, under contract No. 319, as follows:

Set basalt stone 20" x 10" x 4" for corner. Set a stake and built a mound of stone around corner stone and stake in lieu of pits.

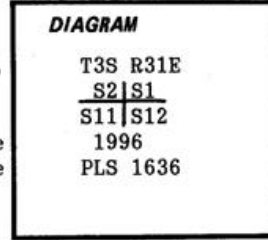

Description of corner evidence found:

The original corner stone, 20" x 14" x 7", is marked with one notch on one sharp edge and one notch/groove on a rounded edge. The original post is down and decayed. The post is squared at the top to 3". No scribes are visible. The post appears to have been originally set 3.0 feet northeast of the corner stone, as evidenced by the remains in the ground. The corner stone is surrounded by a mound of stones.

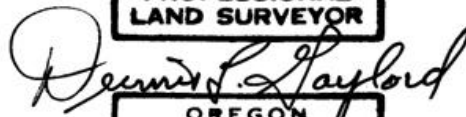**REGISTERED
PROFESSIONAL
LAND SURVEYOR**

OREGON
JULY 14, 1913
DENNIS L. GAYLORD
 1636
Renews 6/30/97

Description of monument and accessories established to perpetuate the original location of this corner:

At the point occupied by the original corner stone, I set a 1 1/2" x 30" galvanized iron pipe 18" into the ground. A 2 1/2" brass cap attached is marked as shown in the diagram, above. I place the original corner stone along the south side of the iron pipe and build a mound of stones around the pipe to the top of the brass cap. I lay the original post on top of the mound of stones. From which:

- A boulder, 24" x 18" x 14" above the ground, is marked "X" on the northwest corner and "BO" on the northwest face. The "X" bears S6°W, 86.4 feet.
- A 5/8" x 24" iron rod, with a 1 1/2" aluminum cap attached, is set 18" into the ground. The cap, which is marked "42.9 LS 1636" with an arrow pointing toward the corner, bears N64°E, 42.9 feet.
- A 5/8" x 24" iron rod, with a 1 1/2" aluminum cap attached, is set 16" into the ground. The cap, which is marked "82.2 LS 1636" with an arrow pointing toward the corner, bears S42°E, 82.2 feet.
- A 5/8" x 36" aluminum rod with an unmarked blue plastic cap attached, is set 33" into the ground. A 5/8" brass washer, marked "PLS 1636", is wired to the rod at ground level. This rod bears N44°W, 75.5 feet.

I hereby certify the above corner point was perpetuated as hereon described on May 5, 1996. Magnetic declination: 20°E.

Office of COUNTY SURVEYOR County of UMATILLA
 State of OREGON, I hereby certify that the within instrument was filed in this office
 for record on the 10 day of May, 1996
Dennis L. Gaylord by _____
 (COUNTY OFFICIAL) (DEPUTY)

RECEIVED BY
 Umatilla County Surveyor
 Date 5-26
 Rec'd By KK
 No. 96-68-L