

USDA-FOREST SERVICE


Index File No. V-23
 T 3S R. 31E
 Merid. Willamette

CORNER RECORD (SEARCH)

(Ref. FSM 7151.4)

R.D. Ukiah County Umatilla
 N.F. Umatilla State Oregon
 Tract or Survey No. Sec 36 Cor. No. N 1/4

CORNER DIAGRAM

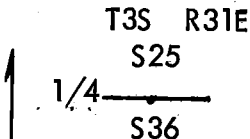

DESCRIBE CORNER MONUMENT FOUND

None.

DESCRIBE BEARING TREES OR OTHER OFFICIAL ACCESSORIES FOUND

A Pine Stump bears N23°W 34.32 ft dist - with vague scribing.
 A 28" dia Tamarack bears S60°E 23.76 ft dist. - with visible scribing.

PHOTO IDENTIFICATION DATA

Photo No. 616140 780-6
 Filed At Umatilla Nat. Forest
 Object Ident. Trees
 Ident. By _____
 Signature _____

DESCRIBE CORNER LOCATION RELATIVE TO NEAR-BY FEATURES, ALSO HOW TO REACH CORNER

Yellow Jacket Road to road #5420, South on road #5420 1.6 miles to cattleguard, then West 1,000 ft to corner on steep East slope 200 ft West of creek.

PLANE COORDINATE POSITION DATA

State _____ Zone _____
 X _____
 Y _____
 Estab. By _____
 Agency _____

Signature William R. Wells

Title PLS 1106

Division _____

Headquarters _____

Date September 30, 1982

7100-52-(3/68)

CORNER RECORD (PERPETUATION)

MONUMENT: DESCRIBE NEW MONUMENT SET, OR WORK DONE TO PRESERVE EXISTING MONUMENT

Set 2 1/2" brass cap on 2 1/2" x 30" l. pipe 18" in ground with mound of stone.

Set steel fence post with 54-2 & 4 signs attached East of corner. Cap marked:

T3S R31E
1/4 S25
S36
1982
PLS 1106

ACCESSORIES: DESCRIBE NEW BT'S WITNESS OBJECTS ETC. ESTABLISHED, OR WORK DONE TO PRESERVE EXISTING EVIDENCE

A 10 1/2" dia Red Fir bears S46°W 72.4 ft dist marked: 1/4 S36 BT.

A 18" dia Red Fir bears N18 1/2°W 40.9 ft dist marked: 1/4 S25 BT.

Blaze faces and 6" band around bearing trees are painted red. Trees tagged with 54-3 & 4 signs. Each new BT has a lower blaze, scribed BT, with brass washer stamped PLS 1106 nailed flush.

Work Done By W.R. Wells Title Surveyor Date 9/30/82 State Registration No. PLS 1106
or Agency

Certified Cor. Record Prepared? Yes No Filed At: Umatilla County Surveyor Office Date

REMARKS

Witnessed by: Leslie E. Wilson

Index File No.

V-23

T.

3S

R.

31E

M.

W.M.

Tract or Surv. No.

Sec 36

Cor.

N 1/4

USDA-FOREST SERVICE

Index File No. V-23

CORNER RECORD (SEARCH)

(Ref. FSM 7151.4)

Tract or Survey No. _____

Cor. No. _____

T 3S R. 31E

R.D. UKIAH


County UMATILLA

Merid. WILL

N.F. UMATILLA

State OREGON

CORNER DIAGRAM

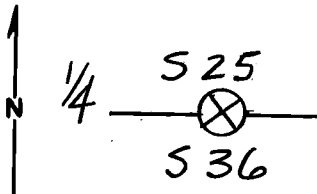

DESCRIBE CORNER MONUMENT FOUND

NONE

DESCRIBE BEARING TREES OR OTHER OFFICIAL ACCESSORIES FOUND

ORIG 20" PINE IS NOW A 42" LARCH WITH A BURNT & NEARLY HEALED BLAZE (LOWER BLAZE BURNT AWAY) DEFINITE FRAGMENTARY SCRIBING IS VISIBLE. BEARS S 62° E, 2376 FT.

ORIG. 16" PINE IS NOW A SAWN STUMP, BADLY DECAYED. FRAGMENTARY SCRIBING, "T" IS VISIBLE ON STUMP FRAGMENT.

DESCRIBE CORNER LOCATION RELATIVE TO NEAR-BY FEATURES, ALSO HOW TO REACH CORNER

CORNER IS LOCATED AT FENCE CORNER.

PHOTO IDENTIFICATION DATA

Photo No. _____
 Filed At. _____
 Object Ident. _____
 Ident. By _____
 Signature _____

PLANE COORDINATE POSITION DATA

State _____ Zone _____
 X _____
 Y _____
 Estab. By _____
 Agency _____

Signature

Title

Division

Headquarters

Date

Dennis L. Laylord

PLS 1636

11-5-80

7100-52-(3.68)

CORNER RECORD (PERPETUATION)

MONUMENT: DESCRIBE NEW MONUMENT SET, OR WORK DONE TO PRESERVE EXISTING MONUMENT

ACCESSORIES : DESCRIBE NEW BT's WITNESS OBJECTS ETC. ESTABLISHED, OR WORK DONE TO PRESERVE EXISTING EVIDENCE

Work Done By _____ Title _____ Date _____ State Registration No. _____
or Agency _____
Certified Cor. Record Prepared? Yes No Filed At: _____ Date _____

REMARKS

Index File No. T. R. M. Tract or Surv. No. Cor.