

Index
File No. X-17

CORNER RECORD (SEARCH)

(Ref. FSM 7151.4)

Tract or Survey No. Sec 34 Cor. No. E 1/4 ¹²

T 3S R. 31E R.D. Ukiah County Umatilla
Merid. Willamette N.F. Umatilla State Oregon

CORNER DIAGRAM

1/4
S34 | S35
T3S R31E



DESCRIBE CORNER MONUMENT FOUND

3" brass cap on 2 1/2" l. pipe in mound of stone.

DESCRIBE BEARING TREES OR OTHER OFFICIAL ACCESSORIES FOUND

A 37" dia P.Pine brs S39°E 11.9 ft dist tagg N40°W 18 lk (old BT, open blaze).

A 28" dia P.Pine brs N87°W 190.8 ft dist tagg S87°E 289 lk dist-recent bl
A Fallen Pine Snag bears West 108 + ft dist. nearly deteriorated - blank tag.

PHOTO IDENTIFICATION DATA

Photo No. 616140 380-4
Filed At. Umatilla Nat. Forest
Object Ident. Trees
Ident. By _____
Signature

DESCRIBE CORNER LOCATION RELATIVE TO NEAR-BY FEATURES, ALSO HOW TO REACH CORNER

Yellow Jacket Road South to road #5420, then South to road #5412-100, then West on road #5412-100 approx. 1.2 miles, then East 70 ft in clearing at East edge of Swiss flats, to corner. Fence corner NW of corner approx. 35 ft.

PLANE COORDINATE POSITION DATA

State _____ Zone _____
X _____
Y _____
Estab. By _____
Agency

Signature
William R. Wells

Title
PLS 1106

Division

Headquarters

Date

October 6, 1982

7100-52 (3-68)

CORNER RECORD (PERPETUATION)

MONUMENT: DESCRIBE NEW MONUMENT SET, OR WORK DONE TO PRESERVE EXISTING MONUMENT

Set steel fence post with 54-4 sign attached, South of corner.
Standard BLM. m Cap marked:

T3S R31E
1/4
S34 | S35
1978

ACCESSORIES : DESCRIBE NEW BT's WITNESS OBJECTS ETC. ESTABLISHED, OR WORK DONE TO PRESERVE EXISTING EVIDENCE

Blaze faces and 6" bands around bearing trees are painted red. Tagged trees with 54-3 and 4 signs, where needed.

Work Done By W.R. Wells Title Surveyor Date 10/6/82 State Registration No. PLS 1106
or Agency

Certified Cor. Record Prepared ? Yes No Filed At: Umatilla County Surveyor Office Date

REMARKS

Witnessed by: Leslie E. Wilson

Index File No. X-17

T.

3S

R.

31E

M.

W.M.

Tract or Surv. No.

Sec 34

Cor.

E 1/4


Index
File No. X-17

CORNER RECORD (SEARCH)

Tract or
Survey No. 5-40 Cor.
No. X-17

T 3S R. 31E R.D. Ukiah County Umatilla
Merid. Willamette N.F. Umatilla State Oregon

CORNER DIAGRAM

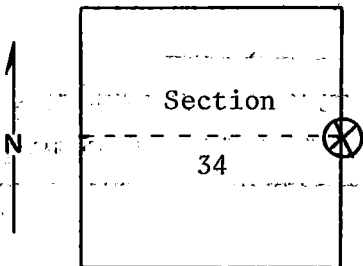

DESCRIBE CORNER MONUMENT FOUND

Material: None.

Original $\frac{1}{4}$ corner was a pine post which would be gone.

2

DESCRIBE BEARING TREES OR OTHER OFFICIAL ACCESSORIES FOUND

A 36-inch p.pine blazed and scribed on NW face. It has an old "Oregon State Board of Forestry" location poster on the west side.

A 30-inch p.pine, down and rotting, lies in the proper location for the west B.T. Its roots are located in the immediate west edge of road. It has some faint marks that may have been scribing.

3

DESCRIBE CORNER LOCATION RELATIVE TO NEAR-BY FEATURES, ALSO HOW TO REACH CORNER

Approximate $\frac{1}{4}$ corner location is about 60 feet east of main road from Carney Butte to Bear Wallow G.S.

See Carney Butte 7.5 minute Quadrant map. A fence corners about 40 feet NW of SE B.T. (the live one). Fences run north and east.

4

PHOTO IDENTIFICATION DATA

Photo No. _____
Filed At. _____
Object Ident. _____
Ident. By _____

Signature

7

PLANE COORDINATE POSITION DATA

State _____ Zone _____
X _____
Y _____
Estab. By _____

Agency

8

Signature

Title

Division

Headquarters

Date

7100-52

T, Hollamon

Engineering Technician

S. O.

November 1, 1974

REV. 65 5

CORNER RECORD (PERPETUATION)

MONUMENT. DESCRIBE NEW MONUMENT SET, OR WORK DONE TO PRESERVE EXISTING MONUMENT

ACCESSORIES : DESCRIBE NEW BT'S WITNESS OBJECTS ETC. ESTABLISHED, OR WORK DONE TO PRESERVE EXISTING EVIDENCE

I placed blank B.T. tags on both the standing and the down B.T.'s.

Work Done By _____ Title _____ Date _____ State Registration No. or Agency _____

Certified Cor. Record Prepared ? Yes No. Filed At: _____ Date _____

REMARKS

Index File No. T. R. M. Tract or Surv. No. Cor. _____