

Index  
File No. X-9

CORNER RECORD (SEARCH)

Tract or  
Survey No. 5-65 Cor.  
No. X-9


T 3S R. 31E

R.D. Ukiah County Umatilla

Merid. Willamette

N.F. Umatilla State Oregon

CORNER DIAGRAM

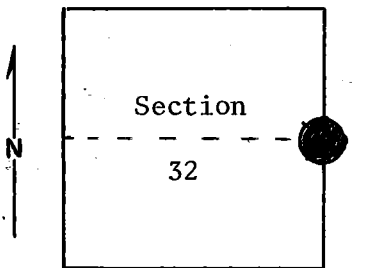

DESCRIBE CORNER MONUMENT FOUND

Material: None.

*monumented by BLM, 1978*

DESCRIBE BEARING TREES OR OTHER OFFICIAL ACCESSORIES FOUND

14" western larch snag blazed, and scribing visible on west face (downhill side).

No other B.T.

PHOTO IDENTIFICATION DATA

Photo No. \_\_\_\_\_

Filed At. \_\_\_\_\_

Object Ident. \_\_\_\_\_

Ident. By \_\_\_\_\_

*Signature*

PLANE COORDINATE POSITION DATA

State \_\_\_\_\_ Zone \_\_\_\_\_

X \_\_\_\_\_

Y \_\_\_\_\_

Estab. By \_\_\_\_\_

*Agency*

DESCRIBE CORNER LOCATION RELATIVE TO NEAR-BY FEATURES, ALSO HOW TO REACH CORNER

$\frac{1}{4}$  corner location is about half way between break of hill (edge of opening) and bottom of ravine. There is faint evidence of an old east-west fence. Some old wire attached to B.T. See Carney Butte 7.5 minute quadrant map for orientation.

Signature:  
T. Hollamon

Title  
Engineering Technician

Division  
Headquarters  
S.O.

Date  
November 21, 1974

7100-52  
REV. 65 5

CORNER RECORD (PERPETUATION)

MONUMENT : DESCRIBE NEW MONUMENT SET, OR WORK DONE TO PRESERVE EXISTING MONUMENT

ACCESSORIES : DESCRIBE NEW BT'S WITNESS OBJECTS ETC. ESTABLISHED, OR WORK DONE TO PRESERVE EXISTING EVIDENCE

Placed blank tag on both the west and the east sides of B.T. snag. Placed location poster 600 feet east on west edge of primitive road. Also placed location poster 450 feet south of B.T., approximately 100 feet north of primitive road.

Work Done By \_\_\_\_\_ Title \_\_\_\_\_ Date \_\_\_\_\_ State Registration No. \_\_\_\_\_  
or Agency \_\_\_\_\_

Certified Cor. Record Prepared ? Yes No Filed At: \_\_\_\_\_ Date \_\_\_\_\_

REMARKS

Index File No. T. R. M. Tract or Surv. No. Cor. \_\_\_\_\_