

USDA-FOREST SERVICE

Index File No. Z-23

CORNER RECORD (SEARCH)

(Ref. FSM 7151.4)

Tract or Survey No. _____ Cor. No. 1/4


T 3S R. 3TE

R.D. Ukiah County Umatilla

Merid. W.M.

N.F. Umatilla State Oregon

CORNER DIAGRAM

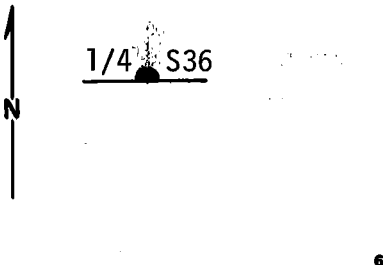

DESCRIBE CORNER MONUMENT FOUND

None Found.

DESCRIBE BEARING TREES OR OTHER OFFICIAL ACCESSORIES FOUND

A Fir 12" in dia. bears N40°E, 10.6 feet partially opened with letter B visible.
Old rotten stump about 7' south lying on the ground. No scribing could be found.

PHOTO IDENTIFICATION DATA

Photo No. _____
Filed At. _____
Object Ident. _____
Ident. By _____
Signature

DESCRIBE CORNER LOCATION RELATIVE TO NEAR-BY FEATURES, ALSO HOW TO REACH CORNER

North about 20' from Forest Service boundary fence.

PLANE COORDINATE POSITION DATA

State _____ Zone _____
X _____
Y _____
Estab. By _____
Agency

Signature

Beverly B. Barbour

Title

P.L.S.

Division

Headquarters

Date

11/8/77

7100-52-(3/68)

CORNER RECORD (PERPETUATION)

MONUMENT : DESCRIBE NEW MONUMENT SET, OR WORK DONE TO PRESERVE EXISTING MONUMENT

At point S40⁰W, 10.6 feet set 2 $\frac{1}{2}$ " x 30" galvanized pipe with brass cap marked:
Set pipe 24" in the ground, with mound of stone around.

T3S	R31E
1/4	S36

T4S	R32E
OR PLS 1051	
1977	

ACCESSORIES : DESCRIBE NEW BT'S WITNESS OBJECTS ETC. ESTABLISHED, OR WORK DONE TO PRESERVE EXISTING EVIDENCE

New BT: A Fir 10" in dia. bears N56⁰W, 14.4 feet, scribed 1/4 S36 BT.
Placed 54-3s and 54-4s and brass washer stamped PLS 1051 on BT blaze.
Painted 6" red band and both blazes red.
Placed 54-2s and 54-4s on fence post 5' west of corner.

Work Done By B.B. Barbour Title P.L.S. Date 11/8/77 State Registration No. OR PLS 1051
or Agency

Certified Cor. Record Prepared ? Yes No Filed At: Date

REMARKS

Witness to the above corner:
D.L. Landers
S. Nelson

Index File No. T. R. M. Tract or Surv. No. Cor.