

RECORD OF LAND CORNER MONUMENTATION

NORTHEAST CORNER SECTION 14, T. 3 S., R. 32 E., W.M.

10	11			11	12
15	14			14	13
15	14			14	13
22	23			23	24

ORIGINALLY ESTABLISHED BY: George S. Pershin, U.S. Deputy Surveyor

CONTRACT NUMBER: 430

CONTRACT DATE: March 23, 1882

SUBSEQUENT SURVEYS:

- ▶ 1987 Remonumentation by Dennis L. Gaylord, PLS #1636, recorded in the Umatilla County Surveyor's office June 29, 1987, as Survey No. 87-27-R.

ORIGINAL DESCRIPTION:

Set a basalt stone 20 x 12 x 5 in. in mound of stone in open glade on level for cor to Sec. 11, 12, 13 and 14 marked with 4 notches on S. and 1 notch on E edges.

A Pine 32 ins. di. brs. S.23°E 133 lks dist marked T3S. R.32E S.13 B.T.

A Pine 28 ins di brs. N.77°W. 183 lks dist marked T3S.R.32E. S.11 B.T. no other trees

1987 REMONUMENTATION:

Gaylord reestablished the corner from the found remains of both original bearing trees. His record states: I Set a 2 1/2 " x 30" aluminum pipe, with a 2 1/2 " aluminum cap attached, 15" into the ground. The cap is marked as shown in the diagram. I build a mound of stones around and over the capped pipe, from which new bearing trees:


- A 13" Ponderosa Pine bears N68°W, 47.9 feet scribed "T3S R32E S11 BT" on a single blaze.
- A 17" Douglas fir bears N11°E, 22.1 feet scribed "T3S R32E S12 BT" on a double blaze.
- A 24" Ponderosa Pine bears S36°E, 104.6 feet scribed "T3S R32E S13 BT" on a single blaze.
- A 16" Ponderosa Pine bears S63°W, 92.6 feet scribed "T3S R32E S14 BT" on a single blaze.

EVIDENCE FOUND: Found 2 1/2 " aluminum pipe with 2 1/2 " aluminum cap (marked as shown below), projecting 16" above ground. The mound of stone had been scattered. From which, a steel T-post with USFS 54-2 and 54-9 signs attached, bears west, 4 ft.

DESCRIPTION OF MONUMENTS AND ACCESSORIES SET AND METHODS USED:

I accept the found monument for the true corner. Rebuilt mound of stone, 3 ft. diameter base to top.

CORNER MONUMENT
MARKED:

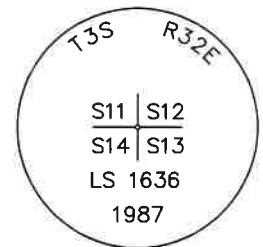

From which, **BEARING TREES BY GAYLORD:**

- ▶ A Douglas-fir, 23" dbh, bears N.14°E., 22.25 ft., with partially-healed blaze.
- ▶ A ponderosa pine, 29" dbh, bears S.33°E., 104.4 ft., with partially-healed blaze.
- ▶ A ponderosa pine, 19" dbh, bears S.61°W., 92.7 ft., with partially-healed blaze.
- ▶ A ponderosa pine, 16" dbh, bears N.65°W., 47.8 ft., with visible scribing in a partially-healed blaze.


Distances to bearing trees measured with a steel tape to a Mag Spike driven in the side-center-right at the root crown of each tree, with an attached 1 1/2" aluminum washer stamped *PLS 69454*. Used RTK GPS to measure bearings, which are geodetic, derived by GPS observation at the corner. Set an aluminum guard post north, 7 ft. with USFS 54-2 sign attached.

RESTORATION BY, STAMP AND DATE:

Work completed June 26, 2024 by:

Jason L. Hatfield, PLS

USDA FOREST SERVICE
NORTHEAST OREGON LAND ZONE
1550 Dewey Avenue, Suite A
Baker City, OR 97814
(541) 523-1283

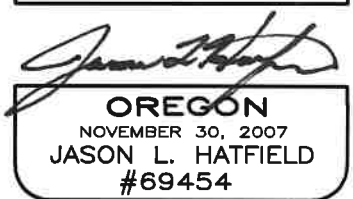

EXPIRES: 6/30/2025

24-078-β