

RECORD OF LAND CORNER MONUMENTATION

WEST 1/4 CORNER SECTION 14, T. 3 S., R. 32 E., W.M.


ORIGINALLY ESTABLISHED BY: George S. Pershin, U.S. Deputy Surveyor

CONTRACT NUMBER: 430

CONTRACT DATE: March 23, 1882

SUBSEQUENT SURVEYS:

- ▶ 1987 Remonumentation by David L. Haddock, PLS #852, recorded in the Umatilla County Surveyor's office November 23, 1987, as Survey No. 87-68-B.

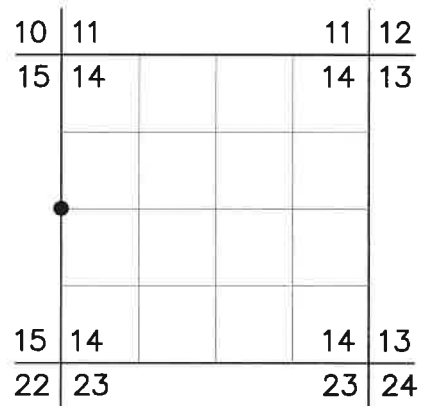

ORIGINAL DESCRIPTION:

Set a basalt stone 20 x 12 x 4 in on rocky point in mound of stone for 1/4 Sec. marked 1/4 on W. face no trees raised a mound of stone alongside.

1987 REMONUMENTATION:

Found small stone mound with 20x12x4 stone with 1/4 chiseled in face...I set a 2" I.D. galvanized iron pipe 30" long with 2 1/2" brass cap stamped as shown in the diagram above. Set pipe 18" into the ground....Scribed 1/4 S15 BT on a 15" Ponderosa Pine which bears N85°30'W, 15.0'. Scribed 1/4 S14 BT on a 10" Ponderosa Pine which bears S1°00'E, 48.7'.

EVIDENCE FOUND: Found 2 1/2" galvanized iron pipe with 2 1/2" brass cap (marked as shown below), projecting 3" from the top of a 4 ft. diameter mound of stone. From which, a T-post bears north, 4.7 feet, with USFS 54-9 sign attached.


DESCRIPTION OF MONUMENTS AND ACCESSORIES SET AND METHODS USED:

I accept the found monument as a perpetuation of the original corner.

From which, **BEARING TREES BY HADDOCK:**

- ▶ A ponderosa pine, 13" dbh, bears S.01°E., 48.7 ft., with healed blaze.
- ▶ A ponderosa pine, 18" dbh, bears N.85°30'W., 15.0 ft., with scribing visible in a partially-healed blaze.

CORNER MONUMENT MARKED:

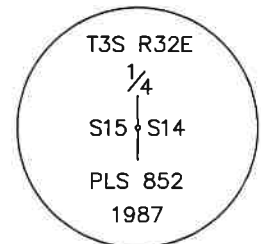

Also from which, **I SET NEW REFERENCE POINTS:**

- ▶ A 5/8"x 24" iron pin bears N.41°54'E., 29.83 ft., with attached 2" aluminum cap marked *RP 1 2024 PLS 69454*
- ▶ A 5/8"x 12" iron pin, driven to bedrock, bears S.41°30'W., 22.52 ft., with attached 2" aluminum cap marked *RP 2 2024 PLS 69454*

Painted a 6 inch red band around each bearing tree, and also painted blazes red and attached new USFS 54-3 and 54-9 signs. Used a magnetic compass with 14° east declination and an EDM to verify record bearings and distances to found BT's. Used RTK GPS to measure reference points. Bearings to reference points are geodetic, based on GPS observation at the corner. Set an aluminum guard post east, 2 ft. with USFS 54-2 sign attached. Removed the found T-post and reset it south, 5 ft., with USFS 54-2 and 54-9 signs attached.

RESTORATION BY, STAMP AND DATE:

Work completed June 25, 2024 by:

Jason L. Hatfield, PLS

USDA FOREST SERVICE
NORTHEAST OREGON LAND ZONE
1550 Dewey Avenue, Suite A
Baker City, OR 97814
(541) 523-1283



EXPIRES: 6/30/2025