

USDA-FOREST SERVICE

Index File No. R-15

CORNER RECORD (SEARCH)

(Ref. FSM 7151.4)

Tract or Survey No. Sec 27 Cor. No. N 1/4


T 3S R. 32E

R.D. Ukiah County Umatilla

Merid. Willamette

N.F. Umatilla State Oregon

CORNER DIAGRAM

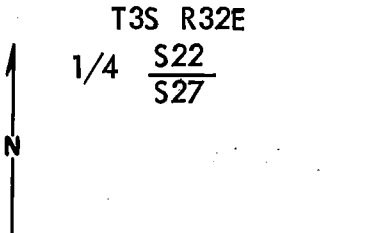

DESCRIBE CORNER MONUMENT FOUND

3" brass cap on 2 1/2" x 28" l. pipe set 26" in ground.

DESCRIBE BEARING TREES OR OTHER OFFICIAL ACCESSORIES FOUND

A 20" dia. Fir bears S45°E 10.0 ft dist ~~Tree~~ Tree down-blaze healed.
 A 16 1/2" dia. Fir bears S45°E 28.8 ft dist tagged N45°W 43 lk-recent blaze.
 A 12" dia. Fir bears N56 1/2°W 26.3 ft dist tagged S56°E 40 1/2 lk-recent blaze.

PHOTO IDENTIFICATION DATA

Photo No. 616140 680-397

Filed At. Umatilla Nat. Forest

Object Ident. Trees

Ident. By _____

Signature

PLANE COORDINATE POSITION DATA

State _____ Zone _____

X _____

Y _____

Estab. By _____

Agency

DESCRIBE CORNER LOCATION RELATIVE TO NEAR-BY FEATURES, ALSO HOW TO REACH CORNER

Road #54 to road #5412, then West to road #5415, then North to road #020, then Northeast to road #022, then Northeast to road #025, then West along road #025 approximately 700 ft then North 200 ft down steep North face to corner.

Signature

Willie R. Wells

Title

PLS 1106

Division

Headquarters

Date

September 23, 1982

7100-52-(3/68)

CORNER RECORD (PERPETUATION)

MONUMENT: DESCRIBE NEW MONUMENT SET, OR WORK DONE TO PRESERVE EXISTING MONUMENT

Set steel fence post with 54-4 sign, on section line near corner.
Cap is standard BLM .

Cap marked:

T3S R32E
1/4 $\frac{S22}{S27}$
1977

ACCESSORIES : DESCRIBE NEW BT'S WITNESS OBJECTS ETC. ESTABLISHED, OR WORK DONE TO PRESERVE EXISTING EVIDENCE

6" band around bearing trees and blaze faces are painted red.
Tagged trees with 54-3 and 4 signs as needed.

Work Done By W. R. Wells Title Surveyor Date 9/23/82 State Registration No. PLS 1106
or Agency

Certified Cor. Record Prepared ? Yes No Filed At Umatilla County Surveyor Office Date

REMARKS

Witnessed by: D. L. Kaufman, PLS

Index File No.
R-15

T.

3S

R.

32E

M.

W.M.

Tract or Surv. No.

Sec 27

Cor.

N 1/4