

Index ⁷
 File No. ~~V-23~~ R-7

CORNER RECORD (SEARCH)

(Ref. FSM 7151.4)

Tract or
 Survey No. _____

Cor.
 No. _____

T 3 S. R. 32 E.

R.D. UKIAH


County Umatilla

Merid. W.

N.F. Umatilla

State ORE.

CORNER DIAGRAM

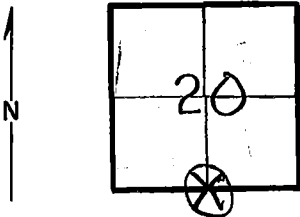

DESCRIBE CORNER MONUMENT FOUND

Stone 12"x10"x6", 8" Above Ground And in good
 Condition, marked 1/4

2

DESCRIBE BEARING TREES OR OTHER OFFICIAL ACCESSORIES FOUND

28" D.B.H. Pond Pine S. 67° W, 115 lks.
 Also Found metal Posters

PHOTO IDENTIFICATION DATA

Photo No. _____

Filed At. _____

Object Ident. _____

Ident. By _____

Signature

7

PLANE COORDINATE POSITION DATA

State _____ Zone _____

X _____

Y _____

Estab. By _____

Agency

8

DESCRIBE CORNER LOCATION RELATIVE TO NEAR-BY FEATURES, ALSO HOW TO REACH CORNER

3

Signature

M.L.C.

Title

For. Tech.

Division

Headquarters

UKIAH

Date

10-5-72

7100-52 (3/68)

4

5

CORNER RECORD (PERPETUATION)

MONUMENT : DESCRIBE NEW MONUMENT SET, OR WORK DONE TO PRESERVE EXISTING MONUMENT

ACCESSORIES : DESCRIBE NEW BT's WITNESS OBJECTS ETC. ESTABLISHED, OR WORK DONE TO PRESERVE EXISTING EVIDENCE

Painted B.t.s with ORANGE Paint

Work Done By _____ Title _____ Date _____ State Registration No. or Agency _____

Certified Cor. Record Prepared ? Yes No Filed At: _____ Date _____

REMARKS

Index File No. T. R. M. Tract or Surv. No. Cor. _____