

(PPA)

Index File No. X-13

CORNER RECORD (SEARCH)

Tract or Survey No. _____ Cor. No. X-13


T 3S R. 32E

R.D. Ukiah County Umatilla

Merid. Willamette

N.F. Umatilla State Oregon

CORNER DIAGRAM

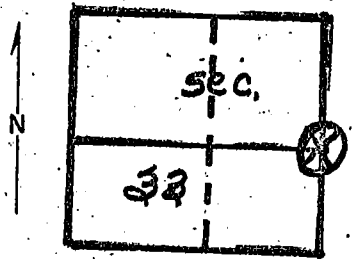

DESCRIBE CORNER MONUMENT FOUND

None was found.

DESCRIBE BEARING TREES OR OTHER OFFICIAL ACCESSORIES FOUND

28" ponderosa pine S 26 degrees E 71 links sec. 34 (fair vigor)

PHOTO IDENTIFICATION DATA

Photo No. _____
 Filed At. _____
 Object Ident. _____
 Ident. By _____
Signature

DESCRIBE CORNER LOCATION RELATIVE TO NEAR-BY FEATURES, ALSO HOW TO REACH CORNER

PLANE COORDINATE POSITION DATA

State _____ Zone _____
 X _____
 Y _____
 Estab. By _____
Agency

Signature: D m^c Cullough Title: For. tech. Division: USFS Headquarters: Ukiah Date: 6/28/67

Index File No. X-13

CORNER RECORD (SEARCH) Tract or Survey No.

Cor. No. 14
24


T 3S R. 32E

R.D. Ukiah County Umatilla

Merid. Willamette

N.F. Umatilla State Oregon

CORNER DIAGRAM

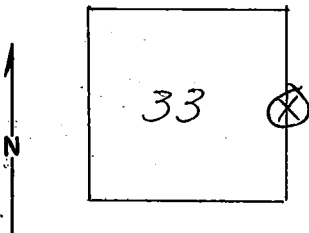

~~DESCRIBE CORNER MONUMENT FOUND~~ Original notes
BT dead PP (fallen over and rotted) S32W 1911ks

found pile of rock to indicate corner.

DESCRIBE BEARING TREES OR OTHER OFFICIAL ACCESSORIES FOUND 2

ran a compass line south, 330' to the $\frac{1}{4}$ corner had the original notes for this corner and found that the pile of rocks check with notes and BT

compass line was run from the Lucky Strike Rd. I guess WAY

PHOTO IDENTIFICATION DATA

Photo No. _____
Filed At. _____
Object Ident. _____
Ident. By _____

Signature 7

PLANE COORDINATE POSITION DATA

State _____ Zone _____
X _____
Y _____
Estab. By _____

Agency 8

DESCRIBE CORNER LOCATION RELATIVE TO NEAR-BY FEATURES, ALSO HOW TO REACH CORNER 3

Signature

Title

Division

Headquarters

Date

7100-52

151 L. Waid

1962

REV. 65 5

CORNER RECORD (PERPETUATION)

MONUMENT: DESCRIBE NEW MONUMENT SET, OR WORK DONE TO PRESERVE EXISTING MONUMENT

9

ACCESSORIES : DESCRIBE NEW BT's WITNESS OBJECTS ETC. ESTABLISHED, OR WORK DONE TO PRESERVE EXISTING EVIDENCE

10

Work Done By _____ Title _____ Date _____ State Registration No. _____
or Agency _____

Certified Cor. Record Prepared ? Yes No Filed At: _____ Date _____

11

REMARKS

12

Index File No. *X-13* T. R. M. Tract or Surv. No. Cor. _____

13