

USDA-FOREST SERVICE

Index File No. A-21

CORNER RECORD (SEARCH)

(Ref. FSM 7151.4)

Tract or Survey No. Sec 2 Cor. No. NEW COR


T 35 R. 33E

R.D. Ukiah County Union

Merid. Willamette

N.F. Umatilla State Oregon

CORNER DIAGRAM

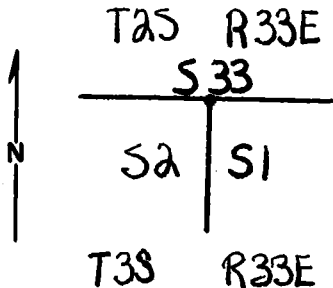

DESCRIBE CORNER MONUMENT FOUND

None

DESCRIBE BEARING TREES OR OTHER OFFICIAL ACCESSORIES FOUND

A 26" pine bears N38° E 17.1 ft to the face of partially healed blaze 18.1 ft to center.
A 22" rotted fir stump scribed R33E S2BT bears S28° W 7.4' to face of blaze 8.6' to center.

PHOTO IDENTIFICATION DATA

Photo No. _____
Filed At. _____
Object Ident. _____
Ident. By _____
Signature

DESCRIBE CORNER LOCATION RELATIVE TO NEAR-BY FEATURES, ALSO HOW TO REACH CORNER

On the East edge of canyon 2' North of fence

PLANE COORDINATE POSITION DATA

State _____ Zone _____
X _____
Y _____
Estab. By _____
Agency

Signature

William R. Wells

Title

PLS 1106

Division

Headquarters

Date

6/28/79

7100-52-(3/68)

CORNER RECORD (PERPETUATION)

MONUMENT: DESCRIBE NEW MONUMENT SET, OR WORK DONE TO PRESERVE EXISTING MONUMENT

Set 2"x30" iron pipe with brass cap set 18" in ground to rock with a mound of stone ground the monument, marked:

T35 R33E
 S33
 S2 | S1
 T35 R33E
 1979 PLS 1106

Set steel fence post 4" + E of corner on Township line and attached signs 54-2 and 54-4.

ACCESSORIES: DESCRIBE NEW BT'S WITNESS OBJECTS ETC. ESTABLISHED, OR WORK DONE TO PRESERVE EXISTING EVIDENCE

A 24" fir bears S31 $\frac{1}{4}$ E 62.9 ft scribed T35 R33E S1 BT

A 17 $\frac{1}{2}$ " red fir bears S14 $^{\circ}$ W 77.1 ft scribed T35 R33E S2 BT

New BT's have a lower blaze scribed BT with brass washer stamped PLS 1106 nailed flush.

Attached signs 54-3 and 54-4 and painted red ring around all BT's.

Work Done By William R. Wells Title PLS Date 6/28/79 State Registration No. 1106
 or Agency

Certified Cor. Record Prepared? Yes No Filed At: _____ Date _____

REMARKS

Witnesses: Greg Flowers, L.S.I.T.
 Brent Reynolds

Index File No. T.35 R. 33E M. WILL. Tract or Surv. No. Sec. 2

Cor. N. 121 Cor 13
 U.S. G.P.O. 1977-725-876/586

Index File No. A-21

CORNER RECORD (SEARCH)


Tract-or Survey No. _____

LL
Cor. No. A-21 ⁸

T 3S R. 33E
Merid. "WILLAMETE"

R.D. UKIAH County Umatilla
N.F. UMATILA State ORE.

CORNER DIAGRAM

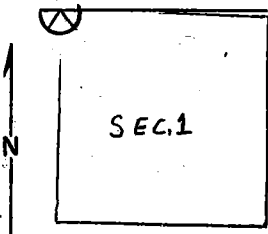

DESCRIBE CORNER MONUMENT FOUND

NONE NO EVIDENCE OF ORIGINAL CORNER POST.

DESCRIBE BEARING TREES OR OTHER OFFICIAL ACCESSORIES FOUND

36" DBH FIR STUMP - 10' HIGH - WITH SCRIBING "R33E S5 BT"
READABLE BEARING S25W 11 LKS FROM COR.
26" DBH PINE BT - BEARING N40°E 26 LKS FROM COR.
FACE OF BLAZE CLOSED - GREEN AND STANDING
NO EVIDENCE OF OTHER BT'S

PHOTO IDENTIFICATION DATA

Photo No. 8-237
Filed At. _____
Object Ident. 48 FT 6" DBH FIR
Ident. By Tom Sutherland
Signature

DESCRIBE CORNER LOCATION RELATIVE TO NEAR-BY FEATURES, ALSO HOW TO REACH CORNER

BOUNDARY FENCE RUNS THROUGH CORNER. TO FIND THE CORNER FOLLOW JEEP ROAD N. OUT RIDGE E. OF SOUTH CANYON TO BOUNDARY FENCE FOLLOW FENCE EAST TO MARKED CORNER FROM LOCATION POSTER FOR N 1/4 COR OF SEC. 2 T3S, R33E.

PLANE COORDINATE POSITION DATA

State _____ Zone _____
X _____
Y _____
Estab. By _____
Agency

Signature:

Mike Lilly

Title
ENG AID

Division
USFS

Headquarters
UMATILA S.O.

Date
8/7/69

7100-52
REV. 65 5

CORNER RECORD (PERPETUATION)

MONUMENT: DESCRIBE NEW MONUMENT SET, OR WORK DONE TO PRESERVE EXISTING MONUMENT

NONE

ACCESSORIES: DESCRIBE NEW BT'S WITNESS OBJECTS ETC. ESTABLISHED, OR WORK DONE TO PRESERVE EXISTING EVIDENCE

PAINTED BT'S RED, PLACED BEARING TREE SIGNS (54-3) ON BT'S
PLACED ATTENTION SIGN ON STANDING BT, PLACED RED FLAGGING ON FENCE

Work Done By T.E. SUTHERLAND Title ENG AID Date 8/7/69 State Registration No. U.S. Forest Service
or Agency

Certified Cor. Record Prepared? Yes No Filed At: _____ Date _____

REMARKS

SCRIBING ON THE PINE BT WAS OBLITERATED AT THE TIME OF THE SURVEY OF T2S R33E.

ON THE FIR BT THERE IS AN ERROR IN THE SCRIBING IT IS IN SECTION 2 INSTEAD OF SECTION 5.

PIN PRICKED A 6" DBH FIR TREE BEARING 54E 181 LKS FROM THE CORNER

Index File No. A-21 T. 3S R. 33E M. WILL Tract or Surv. No. _____ Cor. A-21