

USDA-FOREST SERVICE


Index
File No. A-9
T 3S R. 33E
Merid. Willamette

CORNER RECORD (SEARCH)

(Ref. FSM 7151.4)

Tract or Survey No. Cor. No. Section
R.D. Ukiah County Umatilla
N.F. Umatilla State Oregon

CORNER DIAGRAM

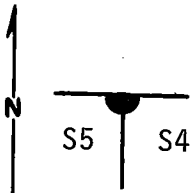

DESCRIBE CORNER MONUMENT FOUND

Could find no evidence of original stone.

DESCRIBE BEARING TREES OR OTHER OFFICIAL ACCESSORIES FOUND

Found 22" Ponderosa Pine with open blaze and visible scribing "T2S R33E S32 BT" scribing is faint. "X" is scribed in bark on back side of BT.

PHOTO IDENTIFICATION DATA

Photo No.
Filed At.
Object Ident.
Ident. By
Signature

PLANE COORDINATE POSITION DATA

State Zone
X:
Y:
Estab. By
Agency

DESCRIBE CORNER LOCATION RELATIVE TO NEAR-BY FEATURES, ALSO HOW TO REACH CORNER

Corner falls approx. 30 ft. south of E-W fence on steep rocky east slope at west edge of large clearing.

Signature

Title

Division

Headquarters

Date

ORLS

1294

9/77

7100-52-(3/68)

CORNER RECORD (PERPETUATION)

T2S R33E

MONUMENT: DESCRIBE NEW MONUMENT SET, OR WORK DONE TO PRESERVE EXISTING MONUMENT

S31

At Record Bearing and distance (S47°E, 87 lks = 57.42')

S5 | S4

Set 2½"x30" Galvanized Pipe with brass cap stamped:

T3S

Set pipe 10" in ground with mound of stone to cap.

1980

OR PLS 1294

9

ACCESSORIES: DESCRIBE NEW BT'S WITNESS OBJECTS ETC. ESTABLISHED, OR WORK DONE TO PRESERVE EXISTING EVIDENCE

New BTS: A Ponderosa Pine 36" dia. bears S80°E, 75.9 ft., scribed T3S R33E S4BT.

A Ponderosa Pine 14" dia. bears S82°W, 151.1 ft., scribed T3S R33E S5 BT.

Attached 54-3 & 54-4 signs to all BTs. Attached brass washer stamped LS 1294 to foot blaze of new BTs. Painted blazes and 6" band around both BTs. red. Attached 54-2 and 54-4 signs to metal post 6' west of corner.

10

Work Done By R.C. Orton Title Party Chief Date 7/29/80 State Registration No. or Agency _____

Certified Cor. Record Prepared? Yes No _____ Filed At: _____ Date _____

11

REMARKS

Witnesses: R. Orton
L. Huntsman
D. Allen

12

Index File No.	T.	R.	M.	Tract or Surv. No.	Cor.	13
A-9	35	33E				

Index File No. A-9


CORNER RECORD (SEARCH)

Tract or Survey No. _____ Cor. No. A-9

T3S R. 33E R.D. Ukiah County Umatilla

Merid. Will. N.F. Umatilla State Oregon

CORNER DIAGRAM

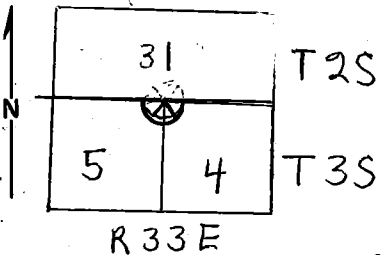

DESCRIBE CORNER MONUMENT FOUND

NONE found.

DESCRIBE BEARING TREES OR OTHER OFFICIAL ACCESSORIES FOUND

Ponderosa Pine BT, 20" DBH, bears approx. N49W, 87 lks. of corner. Scribing reads "T3S R33E (S32BT)

Can have no relationship to Sec. 32. T&M 3/75

PHOTO IDENTIFICATION DATA

Photo No. EQO, 7-246 (9-1-66)

Filed At. _____

Object Ident. BT

Ident. By _____

Signature

PLANE COORDINATE POSITION DATA

State _____ Zone _____

X _____

Y _____

Estab. By _____

Agency

DESCRIBE CORNER LOCATION RELATIVE TO NEAR-BY FEATURES, ALSO HOW TO REACH CORNER

Corner lies on E.-facing slope in clearing above Pearson Creek Road. A fence runs E. and W. 43 lks from the BT. Area found by following a Jeep trail south which parallels Pearson Cr. Rd. on the W. hillside, until road is impassable; then walking and using aerial photos.

Signature: Kent Mason

Title Eng. Aide Division USFS

Headquarters Umatilla-S.O.

Date 8-12-69

7100-52

REV. 65 5

CORNER RECORD (PERPETUATION)

MONUMENT: DESCRIBE NEW MONUMENT SET, OR WORK DONE TO PRESERVE EXISTING MONUMENT

ACCESSORIES : DESCRIBE NEW BT'S WITNESS OBJECTS ETC. ESTABLISHED, OR WORK DONE TO PRESERVE EXISTING EVIDENCE

Posted Attention, BT and Cor location signs.
Flagged and painted BT (red).

Work Done By MARVIN BENSON Title ENG'R RIDE Date 8/12/69 State Registration No. U.S. FOREST SERVICE
or Agency

Certified Cor. Record Prepared ? Yes No Filed At: Date

REMARKS

Only 1 BT was originally scribed.

Index File No. A-9 T. 3S R. 33 E M. Will, Tract or Surv. No. Cor. A-9