


Index File No. V-3  
 T 3S R. 33E  
 Merid. \_\_\_\_\_

**CORNER RECORD (SEARCH)**  
 (Ref. FSM 7151.4)

Tract or Survey No. \_\_\_\_\_ Cor. No. V-3  
 R.D. Ukiah County Umatilla  
 N.F. Umatilla State Oregon

**CORNER DIAGRAM**

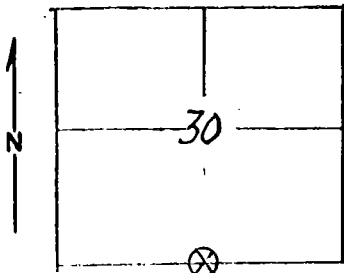

**DESCRIBE CORNER MONUMENT FOUND**

None

**DESCRIBE BEARING TREES OR OTHER OFFICIAL ACCESSORIES FOUND**

A white fir 21.6" in DBH bearing S37°W 16 lks distance is rotten but still green. A white fir 19.3" in DBH bearing N22°E 19 lks is still a young vigorous tree. Both trees have a 6" red band painted around them and the scars are painted also, at which are unmistakably scribing scars for this corner both trees have a b.t. tag on front facing the corner and an attention sign on back. Put up steel post approx. where corner should be, with 3

**PHOTO IDENTIFICATION DATA**

Photo No. \_\_\_\_\_  
 Filed At. \_\_\_\_\_  
 Object Ident. \_\_\_\_\_  
 Ident. By \_\_\_\_\_  
 Signature \_\_\_\_\_

**DESCRIBE CORNER LOCATION RELATIVE TO NEAR-BY FEATURES, ALSO HOW TO REACH CORNER**

The corner is approx. 100' inside fairly dense timber and is about 2/3 of the way from bottom at the beginning of a small draw on the West side of the draw.

**PLANE COORDINATE POSITION DATA**

State \_\_\_\_\_ Zone \_\_\_\_\_  
 X \_\_\_\_\_  
 Y \_\_\_\_\_  
 Estab. By \_\_\_\_\_  
 Agency \_\_\_\_\_

Signature  
 MLC

Title  
 For, Tech,

Division  
 USFS

Headquarters  
 Ukiah

Date  
 6/9/77

7100-52-(3/68)

2  
6  
7  
8  
4  
5