

CORNER RESTORATION FORM

Township 4N Range 28E Section 10, 11, 15, 14 County UMATILLA
 State OREGON Date 5-22-2019 Number J-17

Corner Designation: 10,11, 15, 14

Previous Renewals: ORIGINAL SOURCE OF CORNER

ORIGINALLY SURVEYED IN 1860 BY HAFT UNDER CONTRACT #93. HE SET POST IN

MOUND WITH TRENCH, MADE PITS AND DEPOSITED A PINT OF CHARCOAL.

Accessories Found: _____

NONE.

Condition Report Only

Not Found

Renewed

Surveyed In


Referenced

MONUMENT DETAIL

Found Set

BASIS OF BEARINGS, NAD 83/91 OREGON STATE PLANE
 COORDINATES NORTH ZONE:

NORTHING: 792866.39
 EASTING: 8510422.28

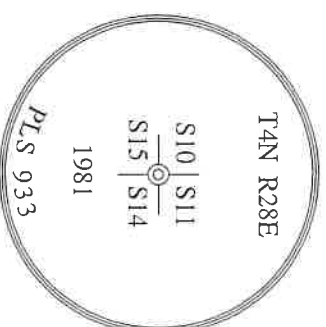

Monument & Accessories Set (Procedure and Description)

- FOUND 2 1/2" BRASS CAP IN MONUMENT WELL 7" BELOW AC, AS PER COUNTY SURVEY S-156-C.
- SET 1 1/2" STEEL WASHER MARKED 61420, IN POWER POLE w/MAG NAIL APPROXIMATELY 2 ABOVE GRADE, N65°43'E 64.85 FT.
- SET 1 1/2" STEEL WASHER MARKED 61420, IN POWER POLE w/MAG NAIL APPROXIMATELY 2 ABOVE GRADE, S43°02'E 62.26 FT.
- SET 1 1/2" STEEL WASHER MARKED 61420, IN POWER POLE w/MAG NAIL APPROXIMATELY 2 ABOVE GRADE, S21°45'W 64.81 FT.
- SET 1 1/2" STEEL WASHER MARKED 61420, IN POWER POLE w/MAG NAIL APPROXIMATELY 2 ABOVE GRADE, N69°46'W 70.58 FT.

Sketch of Monument, Accessories and General Area

**REGISTERED
PROFESSIONAL
LAND SURVEYOR**

[Signature]
ORANGE CLARK KING
MAY 10, 2011
61420

RENEWALS: 6/30/2021

Agency: CK3, LLC
 945 W. ORCHARD
 HERMISTON OREGON 97838
 OFFICE: 541-567-2345
 FAX: 541-567-2305
 WEB: CK3LLC.NET
 Field Book # 0-325

**COUNTY SURVEYOR
RECORDING INFO**

Received _____

Filed _____

Survey No. _____

Drawing No. _____

Index No. J-17

19-080-C