

CORNER RESTORATION FORM

Township 4N Range 28E Section 21 County UMATILLA

State OREGON Date 5-23-2019 Number R-13

Corner Designation: SOUTHWEST CORNER

Previous Renewals: ORIGINAL SOURCE OF CORNER

ORIGINALLY SURVEYED IN 1860 BY HAFT UNDER CONTRACT #93. HE SET POST IN

MOUND w/TRENCH, MADE PITS & DEPOSITED A PINT OF CHARCOAL.

IN 1958 RALPH THOMPSON SET 2" IRON PIPE AT LOCATION OF AN "OLD RUSTED I.P."

Accessories Found: _____

FOUND 5/8" REBAR w/RED CAP PLS 61420, N00°41'W, 33.00 FT.

**BASIS OF BEARINGS, NAD 83/91 OREGON STATE PLANE
COORDINATES NORTH ZONE:**

NORTHING: 782248.17
EASTING: 8505286.74

Condition Report Only

Not Found


Renewed

Surveyed In

Referenced

MONUMENT DETAIL

Found Set

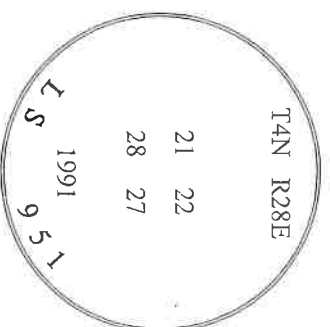

Monument & Accessories Set (Procedure and Description)

FOUND 2 3/8" BRASS CAP 2" BELOW PAVED ROAD IN MON WELL NO LID, AS PER COUNTY SURVEY 92-45-C.

SET 1 1/2" STEEL WASHER MARKED 61420, IN RR TIE w/MAG NAIL APPROX. 2' ABOVE GRADE, S07°47'E, 35.75'.

SET 1 1/2" STEEL WASHER MARKED 61420, IN POWER POLE w/MAG NAIL APPROX. 2' ABOVE GRADE & BEARING OBJECT SIGN,
S40°03'W, 45.72'.

SET 5/8" x 10" IRON REBAR w/RED PLASTIC CAP MARKED PLS 61420, 5' SOUTH OF GAS LINE MARKER, 1' BELOW GRADE,
N88°28'W, 656.25 FT.

N88°28'W, 656.25 FT.

Sketch of Monument, Accessories and General Area

REGISTERED PROFESSIONAL LAND SURVEYOR
Janet Clark King
OREGON
MAY 10, 2019
JANICE CLARK KING
61420

RENEWALS: 6/30/2021

Agency: CK3, LLC
 945 W. ORCHARD
 HERMISTON OREGON 97838
 OFFICE: 541-567-2345
 FAX: 541-567-2305
 WEB: CK3LLC.NET
 Field Book # 0-325

**COUNTY SURVEYOR
RECORDING INFO**

Received _____

Filled _____

Survey No. _____

Drawing No. _____

Index No. R-13

19-080-C