

CORNER RESTORATION FORM

Township 4N Range 28E Section 30, 29, 31, 32 County UMATILLA

State OREGON Date 6-4-2019 Number V-5

Corner Designation : 30, 29, 31, 32

Previous Renewals ORIGINAL SOURCE OF CORNER

ORIGINALLY SURVEYED IN 1860 BY HAFT UNDER CONTRACT #93. HE SET POST IN

MOUND WITH TRENCH, MADE PTS. AND DEPOSITED A PINT OF CHARCOAL.

Accessories Found: _____

NONE.

____ Condition Report Only

____ Not Found

____ Renewed

____ Surveyed In


Referenced

MONUMENT DETAIL

Found Set

BASIS OF BEARINGS, NAD 83/91 OREGON STATE PLANE
COORDINATES NORTH ZONE:

NORTHING: 776920.90
EASTING: 8494762.69

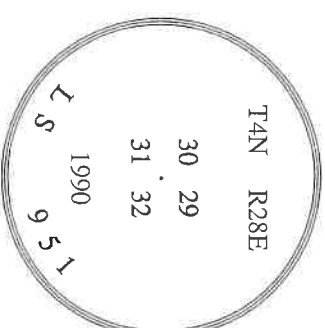

Monument & Accessories Set (Procedure and Description)

FOUND 2 1/2" BRASS CAP 5" BELOW GRADE AS PER COUNTY SURVEY 91-031-B.

SET 5/8" x 10" REBAR & CAP PLS 61420 1' BELOW GRADE, NEAR POWER POLE GUY WIRE ANCHOR, N5°26'E 33.41 FT.

SET 5/8" x 10" REBAR & CAP PLS 61420 1' BELOW GRADE, NEAR POWER POLE GUY WIRE ANCHOR, N36°32'E 28.89 FT.

SET 5/8" x 10" REBAR & CAP PLS 61420 1' BELOW GRADE, NEAR POWER POLE GUY WIRE ANCHOR, S46°16'E 7.25 FT.

SET 5/8" x 10" REBAR & CAP PLS 61420 1' BELOW GRADE, NEAR POWER POLE GUY WIRE ANCHOR, S86°42'W 25.48 FT.

Sketch of Monument, Accessories and General Area

REGISTERED PROFESSIONAL LAND SURVEYOR

Jane Clark King

OREGON
MAY 10, 2011
LANCE CLARK KING
61420

RENEWALS: 6/30/2021

Agency: CK3, LLC
945 W. ORCHARD
HERMISTON OREGON 97838
OFFICE: 541-567-2345
FAX: 541-567-2305
WEB: CK3L.C.NET

Field Book # 0-325

COUNTY SURVEYOR RECORDING INFO

Received _____

Filed _____

Survey No. _____

Drawing No. _____

Index No. V-5

19-080-C