

OREGON CORNER RESTORATION FORM

SECTION 4 TOWNSHIP 4N RANGE 29E E-13

COUNTY: UMATILLA DATE 9/90

CORNER DESIGNATION

South East Corner

- CONDITION REPORT ONLY
- NOT FOUND
- RENEWED
- UNRECORDED
- SURVEYED IN
- REFERENCED OUT



PREVIOUS RENEWALS/SURVEYS, ETC.

Original survey by Davenport in 1861 under Contract #101. He set post.

MONUMENTS & ACCESSORIES FOUND: Condition and Source

Found 1 1/4" Iron pipe ORIGIN UNKNOWN but used as Section Corner in past 15 years. See County Survey #M-43 and #85-105-A.

MONUMENT DETAIL

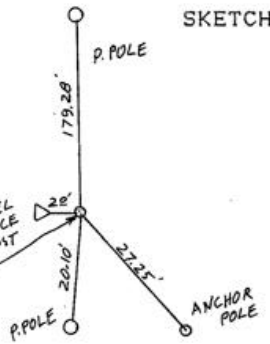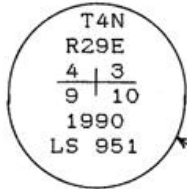

MONUMENT SET (PROCEDURES AND DESCRIPTION)

I poured 8" cylinder of concrete 8" deep over iron pipe and placed 3" Brass Disc over it.

NEW ACCESSORIES

From which

Alum. tag #951 in power pole Bears. N01° 30'W 179.28 feet.
 " " #951 " " " Bears. S05° W 20.10 feet.
 " " #951 in anchor pole Bears. S42° E 27.25 feet.
 Steel fence post Bears. West 2.0 feet.

Attached witness sign to steel fence post and B.O. signs to all.

LOCATION & COMMENTS

From intersection of Loop Road and Edwards Rd., go East on Loop Rd. 1 mile to a dirt lane. Go North 0.25 mile on dirt lane to corner.

COMPASS DEC.
FIRM EDWARDS SURVEYING
 P.O. BOX 763, HERMISTON,
 OREGON, 97838
PARTY CHIEF D. EDWARDS
NOTES
 WITNESS J. COPPOCK

SURVEYOR'S SEAL

**REGISTERED
 PROFESSIONAL
 LAND SURVEYOR**

D. Dennis Edwards

OREGON
 JULY 16, 1974
G. DENNIS EDWARDS
 951

RECEIVED BY

Umatilla County Surveyor
 Date 11-90
 Rec'd by KA
 No. 90-077-B