

OREGON CORNER RESTORATION FORM

COUNTY: Umatilla DATE: October 19, 2011

CORNER DESIGNATION: J-19 South 1/4 Corner Section 11, T. 4 North,
Range 29 E.W.M.

PREVIOUS RENEWALS/SURVEYS ETC.

Timothy Davenport set a post in mound with charred stake (Contract No.101, dated 1861)

John Kimbrell set cedar post and deposited stone coal in a 1905 survey for Inland Irrigation Company, Survey #233, Book 2, Page 16, December, 1905.

G. Dennis Edwards, PLS 951, calculated 1/4 corner position based on holding a railroad spike I set in Survey #95-102-C for easting in a survey for Latham and VanDebrake, Survey #04-106-C.


MONUMENT AND ACCESSORIES FOUND:

Found railroad spike set in Survey #95-102-C.


MONUMENT SET:

Set a 2" aluminum cap on 5/8" X 20 " steel rebar by holding the line between the railroad spike set by Edwards at the center of Section 14 (Survey 04-106-C) and the railroad spike I set at the intersection of East Highland Extension and North Loop Road (Survey #95-102-C) for easting and the line between the section monument set by Edwards at the southeast corner of Section 10 (Survey #11-28-C) and the section monument I set in this survey at the southeast corner of Section 11 for northing.

MONUMENT MARKING DETAIL:

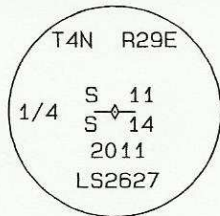

SKETCH: NOT TO SCALE

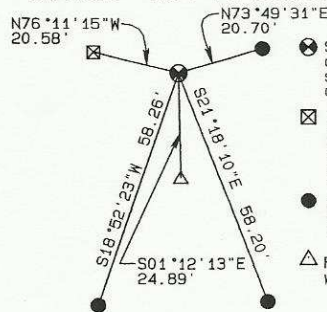

- ⊗ Set 2" aluminum cap on 5/8" X 20" steel rebar at 1/4 corner position
- ⊗ Found 5/8" steel rebar with yellow plastic cap marked "Uma. Co. Rd. Dept. ... LS2627" set in survey #95-102-C
- Set 5/8" X 30" steel rebar with blue plastic cap marked "UCPWD...LS2627"
- △ Found railroad spike set flush with pavement in Survey #95-102-C

NEW ACCESSORIES:

A 5/8" steel rebar with yellow plastic cap marked "UMA. CO. RD. DEPT. ... LS2627" bears N76°11'15"W, 20.58 feet.

A 5/8" X 30" steel rebar with blue plastic cap marked "UCPWD...LS2627" bears N73°49'31"E, 20.70 feet.

A 5/8" X 30" steel rebar with blue plastic cap marked "UCPWD...LS2627" bears S21°18'10"E, 58.20 feet.

A 5/8" X 30" steel rebar with blue plastic cap marked "UCPWD...LS2627" bears S18°52'23"W, 58.26 feet.

A railroad spike set in Survey #95-102-C bears S01°12'13"E, 24.89 feet.

LOCATION AND COMMENTS:

Corner is at the intersection of East Highland Extension and North Loop Road.

COMPASS DECLINATION:

N/A
FIRM/AGENCY:
Umatilla County Road Department
3920 Westgate
Pendleton, Oregon 97801

PARTY CHIEF:
Gary Roberts

NOTES:
N/A

WITNESS:
Matthew Kenny, LSIT

SURVEYOR'S SEAL

REGISTERED
PROFESSIONAL
LAND SURVEYOR

Gary R. Roberts

OREGON
JULY 20, 1993
GARY R. ROBERTS
2627

RENEWS 12/31/2012

11-121-C