

# CORNER RESTORATION FORM

Township 4N Range 29E Section 17 & 20 County UMATILLA

State OREGON Date 3/30/2023 Number N-7  Condition Report Only

Corner Designation : 1/4 CORNER: 17, 20


- Not Found
- Renewed
- Surveyed In
- Referenced

Previous Renewals ORIGINAL SOURCE OF CORNER

ORIGINALLY SURVEYED IN 1861 BY DAVENPORT UNDER  
 CONTRACT #101, HE SET A STAKE IN MOUND OF EARTH  
 1995 EDWARDS SET A 2 3/8" BRASS CAP, COUNTY SURVEY  
 NO. 95-059-B

## MONUMENT DETAIL

Found  Set

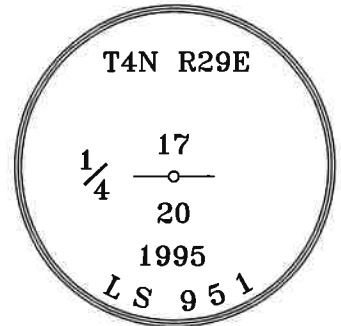

BASIS OF BEARINGS, NAD 83/91 OREGON STATE PLANE  
 COORDINATES NORTH ZONE:

NORTHING: 787810.27  
 EASTING: 8529615.34

### Monument & Accessories Set/Found (Procedure and Description)

AT CORNER FOUND 2 3/8" BRASS CAP 6" BELOW GRADE & SET UMATILLA MON. SIGN, COUNTY

SURVEY NO. 95-059-B


FOUND A ALUMINUM TAG 951 ON P.P S 76°37' W 610.04', CORNER FORM NO. N7-95-59-B

FOUND A ALUMINUM TAG 951 ON P.P S 16°24' E 484.84', CORNER FORM NO. N7-95-59-B

FOUND A 5/8" IRON ROD W/PLASTIC CAP 951 2" BELOW GRADE N 00°50' W 10.03', CORNER FORM NO. N7-95-59-B

FOUND A 5/8" I.R. W/YPC "PLS LS 48490" 2" BELOW GRADE S 88°26' E 82.65', CORNER FORM NO. N7-21-004-C

### Sketch of Monument, Accessories and General Area

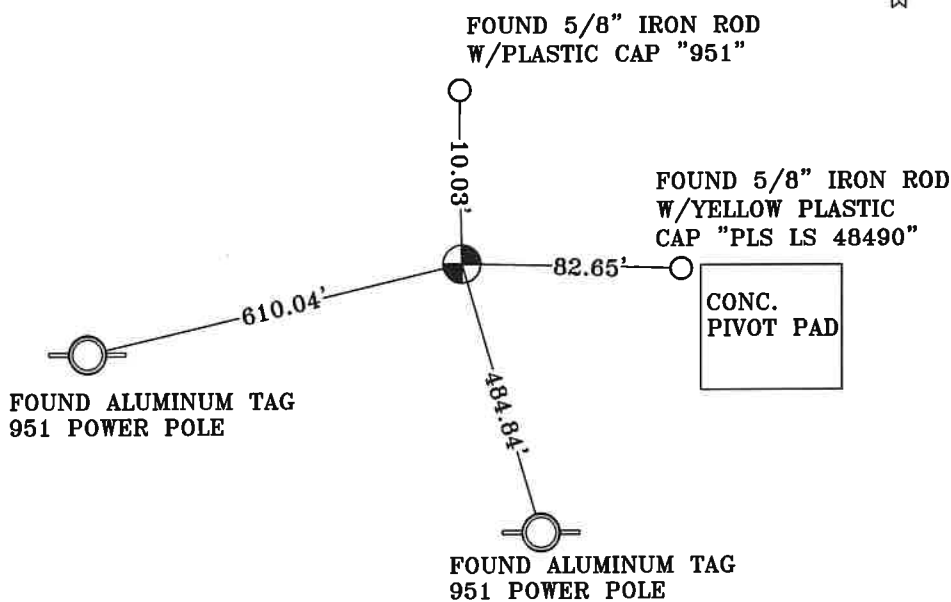

**REGISTERED  
 PROFESSIONAL  
 LAND SURVEYOR**

*Lance Clark King*  
**OREGON  
 MAY 10, 2011  
 LANCE CLARK KING  
 61420**

**RENEWS: 6/30/2023**

**Agency:**  
 CK3, LLC  
 945 W. ORCHARD  
 HERMISTON OREGON 97838  
 OFFICE: 541-567-2345  
 FAX: 541-567-2305  
 WEB: CK3LLC.NET  
 Field Book # 0-350

**COUNTY SURVEYOR  
 RECORDING INFO**

Received CT  
 Filed 5/4/23  
 Survey No. 23-042-C  
 Drawing No. \_\_\_\_\_  
 Index No. N-7