

# CORNER RESTORATION FORM

Township 4N Range 29E Section 28, 29 County UMATILLA

State OREGON Date 3/30/2023 Number T-9

Corner Designation : 1/4 CORNER: 28, 29

Condition Report Only

Not Found

Renewed

Surveyed In

Referenced

Previous Renewals ORIGINAL SOURCE OF CORNER

ORIGINALLY SURVEYED IN 1861 BY DAVENPORT UNDER

CONTRACT #101, HE SET A STAKE IN MOUND OF EARTH

1995 EDWARDS SET A 1"X30" I.P. W/ 2-3/8" BRASS CAP BY

SINGLE PROPORTION COUNTY SURVEY NO. 95-060-B &

CORNER FORM NO. T9-95-060-B


### MONUMENT DETAIL

Found  Set

BASIS OF BEARINGS, NAD 83/91 OREGON STATE PLANE  
COORDINATES NORTH ZONE:

NORTHING: 779929.61

EASTING: 8532393.99

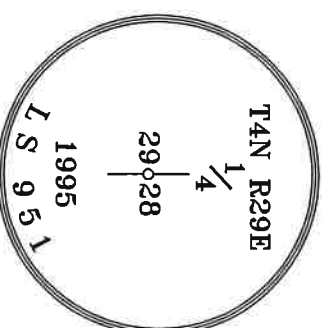

Monument & Accessories Set/Found (Procedure and Description)

AT CORNER FOUND 2 3/8" BRASS CAP 6" BELOW GRADE, COUNTY SURVEY NO. 95-060-B & CORNER FORM NO. T9-95-060-B


FOUND A 5/8" IRON ROD N 88°01' E 53.05', CORNER FORM NO. T9-95-060-B

FOUND A 1/2"X24" IRON ROD W/YELLOW PLASTIC CAP 951 S 88°01' W 18.95', CORNER FORM NO. T9-95-060-B

SET A P.K. NAIL W/WASHER "PLS 61420" & UMATILLA MON. SIGN ON P.P. N 36°36' E 31.99'

SET A 5/8" I.R. W/RPC "PLS 61420" 2" DEEP S 13°22' E 47.51'

### Sketch of Monument, Accessories and General Area

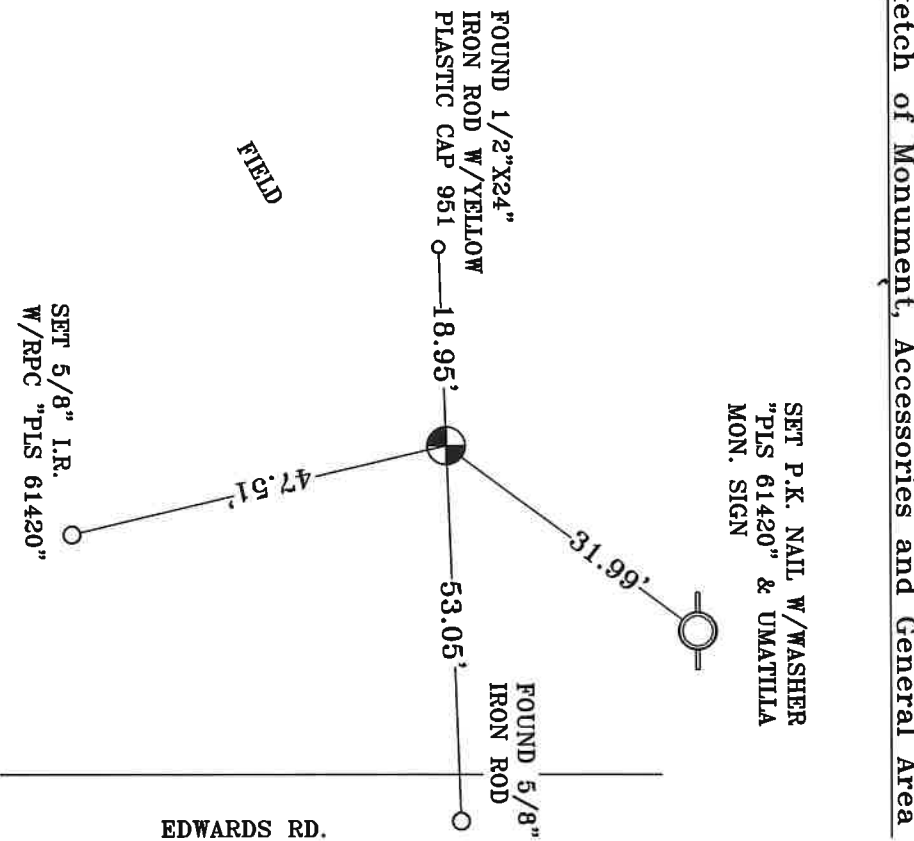

**REGISTERED  
PROFESSIONAL  
LAND SURVEYOR**

*Lance Clark King*  
**OREGON**  
MAY 10, 2011  
LANCE CLARK KING  
61420

**RENEWALS: 6/30/2023**

Agency: **CK3, LLC**  
945 W. ORCHARD  
HERMISTON OREGON 97838  
OFFICE: 541-567-2345  
FAX: 541-567-2305  
WEB: CK3ILC.NET  
Field Book # 0-350

COUNTY SURVEYOR  
RECORDING INFO

Received CT

Filed 5/4/23

Survey No. 23-042-C

Drawing No. \_\_\_\_\_

Index No. T-9