

# OREGON COUNTY RESTORATION FOOTING

SECTION 35 TOWNSHIP 4 NORTH RANGE 29 EAST V-19  
COUNTY : UMATILLA DATE 11-2001

### CORNER DESIGNATION

NORTH 1/4

- CONDITION REPORT ONLY
- NOT FOUND
- RENEWED
- UNCOVERED
- SURVEYED IN
- REFERENCED

### PREVIOUS RENEWALS / SURVEYS, ETC.

ORIGINALLY SURVEYED IN 1860 BY DAVENPORT UNDER CONTRACT #101. HE SET A POST IN A MOUND OF EARTH AND A CHARRED STAKE.  
IN 1998 EDWARDS SET A 1"X30" IRON PIPE WITH A 2 3/8" BRASS CAP.


### MONUMENTS AND ACCESSORIES FOUND: CONDITION AND SOURCE

FOUND A 2 3/8" BRASS CAP STAMPED AS BELOW.  
FROM WHICH:


- A 5/8"X30" IRON REBAR WITH PLASTIC CAP #951 BEARS N 89°10'38" E 43.90 FEET.
- A 5/8"X30" IRON REBAR WITH PLASTIC CAP #951 BEARS N 89°52'52" W 20.07 FEET.
- A 5/8"X30" IRON REBAR WITH PLASTIC CAP #951 BEARS S 89°44'28" W 30.50 FEET.
- AN ALUMINUM TAG #951 IN A R.R. TIE FENCE POST BEARS S 79°31'52" E 123.87'

### SKETCH

### MONUMENT DETAIL

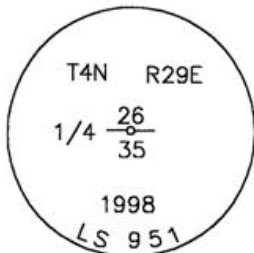

NAD 83/91  
OREGON STATE PLANE  
INTERNATIONAL FEET  
777660.0029  
8545583.7497

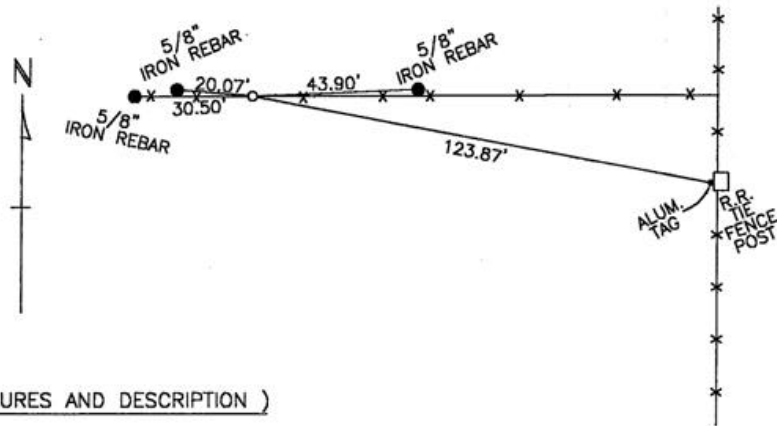

### MONUMENT SET ( PROCEDURES AND DESCRIPTION )

### NEW ACCESSORIES FROM WHICH

### LOCATION AND COMMENTS

### COMPASS DEC.

FIRM/AGENCY  
EDWARDS SURVEYING  
P.O. BOX 763  
HERMISTON, OREGON 97838

PARTY CHIEF  
CURTIS FAVOREL

### NOTES

WITNESS  
WALT MUNDRELL

### RECEIVED BY

Umatilla County Surveyor

Date 11-12-01

Rec'd By KF

No. 01-213-9

### SURVEYOR'S SEAL

REGISTERED  
PROFESSIONAL  
LAND SURVEYOR

*G. Dennis Edwards*

OREGON  
JULY 16, 1971  
G. DENNIS EDWARDS  
9 5 1  
RENEWS 12/31/2001