

CORNER RESTORATION FORM

Township 4N Range 29E Section 26, 35 County UMATILLA

State OREGON Date 3/30/2023 Number V-19

Corner Designation : 1/4 CORNER: 26, 35

Condition Report Only

Not Found

Renewed

Surveyed In

Referenced

Previous Renewals ORIGINAL SOURCE OF CORNER
 ORIGINALLY SURVEYED IN 1860 BY DAVENPORT UNDER
 CONTRACT #101, HE SET A STAKE IN MOUND OF EARTH

MONUMENT DETAIL


1998 EDWARDS SET A 1"X30" I.P. W/2 3/8" BRASS CAP

Found Set

COUNTY SURVEY NO. 98-213-C

BASIS OF BEARINGS, NAD 83/91 OREGON STATE PLANE
 COORDINATES NORTH ZONE:


NORTHING: 777660.11
 EASTING: 8545583.73

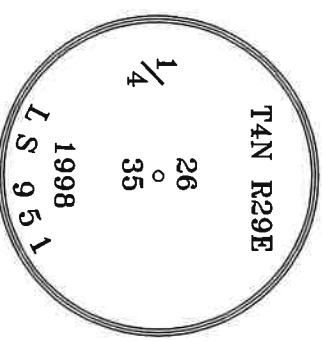

Monument & Accessories Set/Found (Procedure and Description)

AT CORNER FOUND A 2 3/8" BRASS CAP 2" ABOVE GRADE W/ UMATILLA MON. SIGN, COUNTY SURVEY NO. 98-;
 FOUND A 5/8" IRON ROD W/PLASTIC CAP 951 1' BELOW GRADE LEANING SOUTH STRAIGHTENED
 N 89°01' E 43.85', CORNER FORM V19-98-213-C
 FOUND A 5/8" IRON ROD NO CAP S 38°59' W 0.63' ORIGIN UNKNOWN
 FOUND A 5/8" IRON ROD W/PLASTIC CAP 951 S 18°13' W 0.17'
 SET 5/8" I.R. W/RPC "PLS 61420" N 84°07' W 16.29'
 SET 5/8" I.R. W/RPC "PLS 61420" N 26°03' E 2.93'
 SET 5/8" I.R. W/RPC "PLS 61420" S 24°32' W 821.41'

Sketch of Monument, Accessories and General Area

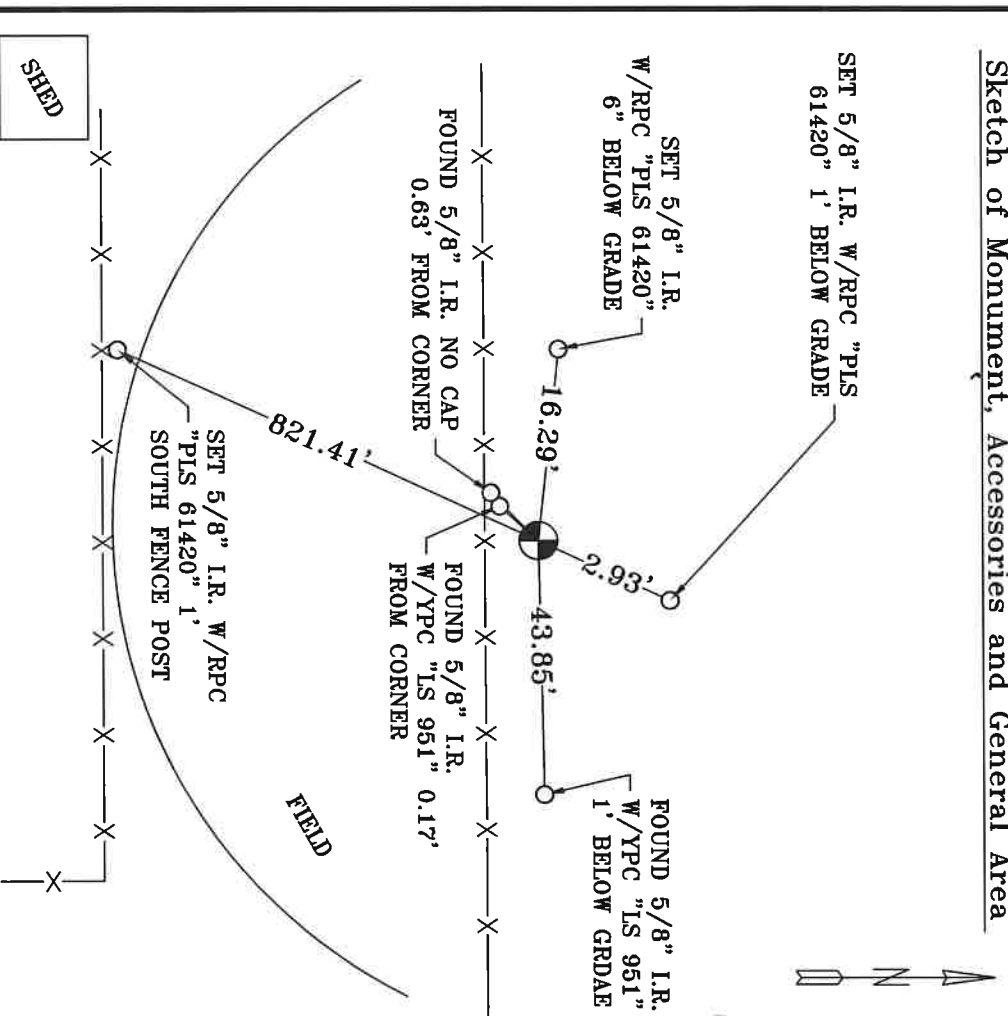

**REGISTERED
 PROFESSIONAL
 LAND SURVEYOR**

Lance Clark King
OREGON
 MAY 10, 2011
LANCE CLARK KING
 61420

RENEWALS: 6/30/2023
 Agency: **CK3, LLC**
 945 W. ORCHARD
 HERMISTON OREGON 97838
 OFFICE: 541-567-2345
 FAX: 541-567-2305
 WEB: CK3ILC.NET
 Field Book# 0-350

**COUNTY SURVEYOR
 RECORDING INFO**

Received CT
 Filed 5/4/23
 Survey No. 23-042-C
 Drawing No. _____
 Index No. V-19