

# OREGON CORNER RESTORATION FORM

SECTION 34 TOWNSHIP 4 NORTH RANGE 29 EAST Z-17  
 COUNTY : UMATILLA DATE 8-98

CORNER DESIGNATION

SE CORNER

CONDITION REPORT ONLY  
 NOT FOUND  
 RENEWED  
 UNCOVERED  
 SURVEYED IN  
 REFERENCED



PREVIOUS RENEWALS / SURVEYS, ETC.

ORIGINALLY SURVEYED IN 1859 BY GATES UNDER CONTRACT #84. HE SET A POST IN A MOUND OF DIRT.

MONUMENTS AND ACCESSORIES FOUND: CONDITION AND SOURCE

NOTHING

MONUMENT DETAIL

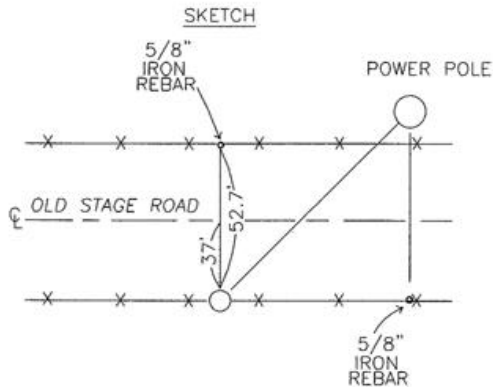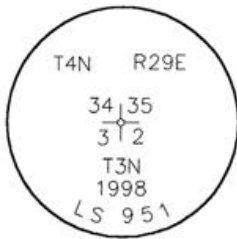

MONUMENT SET ( PROCEDURES AND DESCRIPTION )

BY SINGLE PROPORTION I SET A 1" X 30" IRON PIPE WITH A 2 3/8" BRASS CAP STAMPED AS ABOVE, 3" ABOVE THE SURFACE.

NEW ACCESSORIES FROM WHICH

AN ALUMINUM TAG #951 ON A POWER POLE LIES N 46°.36'00" E, 78.74 FEET.  
 AN ALUMINUM TAG #951 ON A RXR TIE FENCE POST LIES N 87°.39'00" W, 27.21 FEET.  
 A 5/8" X 30" IRON REBAR WITH PLASTIC CAP #951 LIES N 86°.20'26" E, 78.70 FEET.  
 A 5/8" X 30" IRON REBAR AND PLASTIC CAP #951 LIES N 0°.10'03" W, 52.71 FEET.

LOCATION AND COMMENTS

COMPASS DEC.

SURVEYOR'S SEAL

FIRM/AGENCY  
 EDWARDS SURVEYING  
 P.O. BOX 763  
 HERMISTON, OREGON 97838  
 97838

PARTY CHIEF  
 D. EDWARDS

NOTES

WITNESS  
 CURTIS J FAVOREL

**RECEIVED BY**  
 Umatilla County Surveyor  
 Date 10-98  
 Rec'd By AK  
 No. 98-213-0

REGISTERED  
 PROFESSIONAL  
 LAND SURVEYOR

*G. Dennis Edwards*

OREGON  
 JULY 16, 1971  
 G. DENNIS EDWARDS  
 951  
 RENEWS 12/31/99