

CORNER RESTORATION FORM

Township 3N & 4N Range 30E Section 35,36,2&1 County UMATILLA

State OREGON Date 4-8-2015 Number A-21

Corner Designation : SECTION 35, 36, 2 & 1

Condition Report Only
 Not Found
 Renewed
 Surveyed In
 Referenced


Previous Renewals ORIGINAL SOURCE OF CORNER

UNDER GLO CONTRACT #84 BY N. GATES DATED
JULY 22, 1859 SET POST

Accessories Found:
NONE

MONUMENT DETAIL

Found Set

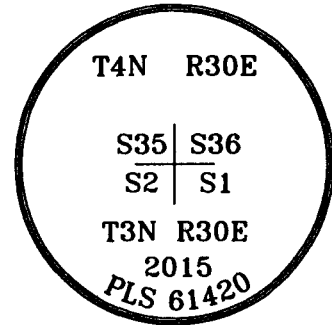

BASIS OF BEARINGS, NAD 83/91 OREGON STATE PLANE COORDINATES NORTH ZONE:

NORTHING: 773045.034
EASTING: 8580570.268

Monument & Accessories Set (Procedure and Description)

- SET 2 1/2" BRASS CAP ON 1 1/4"x30" PIPE AT GRADE ON BERM, MARKER SIGN ON GREEN STEEL POST.
- SET 5/8" REBAR & CAP PLS 61420 AT GRADE IN FENCE LINE, N12°04'E 124.15'.
- SET 5/8" REBAR & CAP PLS 61420 0.5' BELOW GRADE ON ROAD BANK, S54°50'E 33.26'.
- FOUND 1 3/4" STEEL CAPPED PIPE, STAMPED PLS 61420, 0.5' ABOVE GRADE ON BERM, S0°01'E 65.48'.
- SET PK & TAG PLS 61420 WITH BEARING OBJECT SIGN ON POWER POLE, N10°26'W 26.47'.

Sketch of Monument, Accessories and General Area

SET PK & TAG PLS 61420 WITH BEARING OBJECT SIGN ON POWER POLE
 SET 2 1/2" BRASS CAP ON 1 1/4"x30" PIPE AT GRADE ON BERM, MARKER SIGN ON GREEN STEEL POST
 FOUND 1 3/4" STEEL CAPPED PIPE STAMPED PLS 61420 0.5' ABOVE GRADE ON BERM
 SET 5/8" REBAR & CAP PLS 61420 AT GRADE IN FENCE LINE
 SET 5/8" REBAR & CAP PLS 61420 0.5' BELOW GRADE ON ROAD BANK

Bearings and Distances:
 N10°26'W 26.47'
 N12°04'E 124.15'
 S0°01'E 65.48'
 S54°50'E 33.26'
 15'± (width of road)

REGISTERED PROFESSIONAL LAND SURVEYOR

Lance Clark King

OREGON
MAY 10, 2011
LANCE CLARK KING
61420

RENEWS: 6/30/2015

Agency:
CK3, LLC
945 W. ORCHARD
HERMISTON OREGON 97838
OFFICE: 541-567-2345
FAX: 541-567-2305
WEB: CK3LLC.NET
Field Book # 0-289

COUNTY SURVEYOR RECORDING INFO

Received *Jay Robert*

Filed 6/12/2015

Survey No. 15-050-C

Drawing No. C-853

Index No. A-21