

OREGON CORNER RESTORATION FORM

COUNTY: Umatilla DATE: 04/18/19

CORNER DESIGNATION: R-9, The Southwest Corner of Section 21, Township 4 North, Range 32 East, W.M.

PREVIOUS RENEWALS/SURVEYS ETC.: Corner originally set by Odell and Lewis under Contract No. 110, dated February 7, 1865. Notes state: Set post corner for sections on side hill sloping South, drove charred stake, dug pits-raised mounds per instructions.

MONUMENT AND ACCESSORIES FOUND: None. Held the intersection of the centerline of Eggers Road North and South, and a field berm extending West as the best remaining evidence of the original corner.

MONUMENT MARKING DETAIL:

T4N R32E

S20|S21

S29|S28

2019

PLS 54657

MONUMENT SET: At the corner point set a 5/8"x24" iron rebar with a 2" aluminum cap with the top 14" below ground level in road bed. Because of the rocky road bed below grade I was not able to dig deep enough to set a brass cap monument. Monument marked as shown in "Monument Marking Detail".

From which:

A 5/8"x24" rebar with 1 1/4" blue plastic cap stamped "Wells Surveying PLS54657", 1" above ground level in road berm bears Grid Azimuth 18°47'54", 28.9 feet (ground distance).

A 5/8"x24" rebar with 1 1/4" blue plastic cap stamped "Wells Surveying PLS54657", 1" above ground level in road berm bears Grid Azimuth 159°15'19", 30.3 feet (ground distance).

A blue Deep-1 magnet buried 22" below ground level in farmed field bears Grid Azimuth 222°50'37", 28.6 feet (ground distance).

A orange Deep-1 magnet buried 22" below ground level in farmed field bears Grid Azimuth 312°29'45", 31.1 feet (ground distance).

Wired bearing object signs to rebar. Buried bearing object signs with magnets.


LOCATION AND COMMENTS: Corner is located at intersection of Eggers Road running North and South and a farmed field berm extending West.

NAD 83(2011) EPOCH 2010.00, COORDINATES NORTH 784061.01, EAST 8628239.32

FIRM: Wells Surveying
P.O. Box 1696
Pendleton, OR 97801

COMPASS DECLINATION: 18° East Surveyor's Seal

/4N32R9

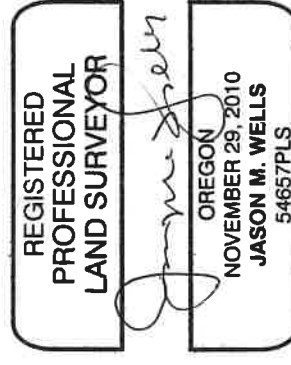

RENEWS: 6:30:20

19-039-β