

OREGON CORNER RESTORATION FORM

Section 2 Township 4N Range 33E
 County Umatilla Date: January 7, 2000


Corner Designation: 4N33C17

Quarter corner for Sections 2 and 3,
 T4N, R33E, W.M.

Condition Report Only
 Not found
 Remonumented
 Unrecorded
 Surveyed in
 Referenced out

Previous Renewals / Surveys, etc.
 Corner originally surveyed and set by Odell and Lewis under contract #110,
 dated February 7, 1865.
 Their record reads: Set 1/4 Sec. post, drove charred stake, dug pits & raised mound.

Monument and Accessories found: (condition and source)
 Found intersection of fence from south and fence from west.

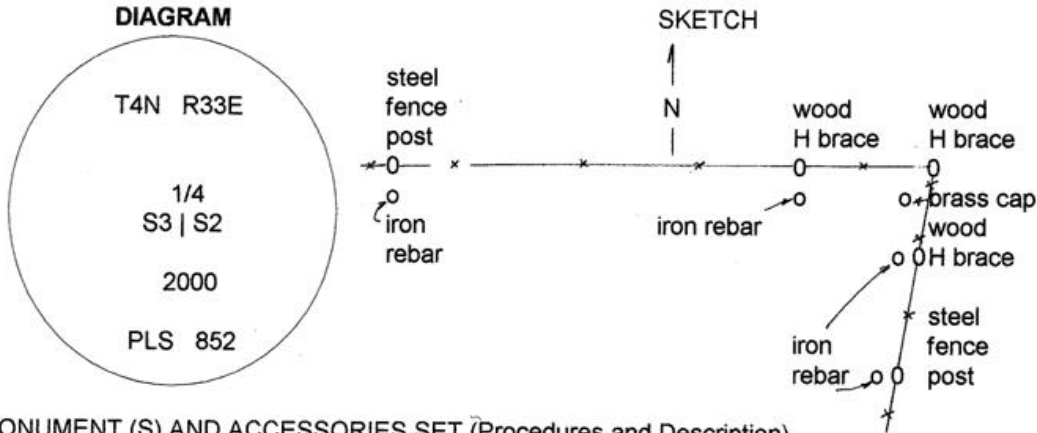

MONUMENT (S) AND ACCESSORIES SET (Procedures and Description)
 At a point just southwest of the fence intersection, I set a 1.25" x 30" galvanized iron pipe with a 2.25" brass cap stamped as shown in the diagram above, flush with ground surface.

REFERENCES SET:
 I set 4 - 5/8" x 24" iron rebars with 1.25" plastic caps stamped ORLS 852 and WALS 13922 as described below:
 An iron rebar bears N85°58'W, 33.97 feet with the plastic cap flush with the ground surface.
 An iron rebar bears S83°39'W, 8.61 feet with the plastic cap flush with the ground surface.
 An iron rebar bears S6°47'W, 6.94 feet with the plastic cap flush with the ground surface.
 An iron rebar bears S6°23'W, 35.26 feet with the plastic cap flush with the ground surface.

Location and comments
 From the junction of Harper Road with Columbia Street at the west side of Helix, follow the fence line Northerly one half mile to the fence corner.

Compass Declination
 20° west

Surveyors Seal

RECEIVED BY:
Umatilla County Surveyor
 Date: _____
 Rec'd By: _____
 No. 99-297-B

Firm / Agency
 Haddock Surveying
 Address
 P.O. Box 1574
 Pendleton, Or. 97801
 Party Chief
 David L. Haddock

REGISTERED
 PROFESSIONAL
 LAND SURVEYOR

David L. Haddock

OREGON
 JULY 12, 1968
 DAVID L. HADDOCK
 852