

OREGON CORNER RESTORATION FORM

COUNTY: Umatilla. DATE: 10/05/18.

CORNER DESIGNATION: E-7, The North 1/4 corner of Section 8, Township 4 North, Range 33 East, W.M.

PREVIOUS RENEWALS/SURVEYS ETC: Corner was originally established by Odell and Lewis, Deputy Surveyors, under Contract No. 110, dated February 7, 1865. Notes state:

Set 1/4 Sec. post. Drove charred stake. Dug pits and raised mound as per instructions.

MONUMENT AND ACCESSORIES FOUND: None. Reestablished corner point at the intersection of centerline Holdman Road, (East-West) and Myrick Road extending South.

MONUMENT MARKING DETAIL:

+
PLS
1106

MONUMENT SET: Set a railroad spike in asphalt road at pavement surface. Spike is marked as shown in Monument Marking Detail.

New accessories:

The base of a yellow directional road sign bears N 14° E, 19.0'.
The top of a telephone pedestal bears S 26° E, 46.6'.
A brass washer stamped "PLS 1106", nailed to the side of Pacific Power Pole No. 084902, 1' above ground line bears S 15 1/2° W, 76.1'.
A brass washer stamped "PLS 1106", nailed to the side of Pacific Power Pole No. 084901, 1' above ground line bears S 41° W, 37.8'.


Nailed "bearing object" signs to the power poles with brass washer accessories.

LOCATION AND COMMENTS: Corner is located at the intersection centerline of Holdman Road with the centerline of Myrick Road extending South.

FIRM: Wells Surveying
P.O. Box 1696
Pendleton, OR 97801

Surveyor's Seal

IAN33E-7

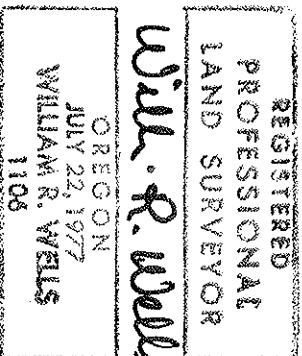

renews 6-30-20

RECEIVED BY
Umatilla County Surveyor
Date: 10/11/2018
Rec'd By: TMA#
No.: 18-087-R