

OREGON CORNER RESTORATION FORM

COUNTY: Umatilla. DATE: 10/05/18.

CORNER DESIGNATION: G-5, The East 1/4 corner of Section 18, Township 4 North, Range 33 East, W.M.

PREVIOUS RENEWALS/SURVEYS ETC: Corner was originally established by Odell and Lewis, Deputy Surveyors, under Contract No. 110, dated February 7, 1865. Notes state:

Set 1/4 Sec. Post, drove charred stake. Dug pits and raised mound as per instructions.

MONUMENT AND ACCESSORIES FOUND: None. Reestablished corner at mid-point latitude between the Northwest and Southwest corners of Section 8 and shifted due East to intersect old North-South field berm.

MONUMENT MARKING DETAIL:

T4N R33E
1/4
S7 | S8
2018
PLS 1106

MONUMENT SET: Set a 2 3/8" brass cap on 1 1/4 by 30" galvanized iron pipe 29 inches in the ground. Cap marked as shown in Monument Marking Detail.

New accessories:

- A silver Deep 1 magnet bears N 0 1/2° W, 26.3'.
- A orange Deep 1 magnet bears N 0 1/2° W, 10.2'.
- A purple Deep 1 magnet bears South, 10.2'.
- A blue Deep 1 magnet bears South, 24.9'.

Deep 1 magnets are buried 15" below ground line. "Bearing object" signs are buried beside each Deep 1 magnet.

Set steel fence post 1.5' North of corner and attached "Witness" sign.


LOCATION AND COMMENTS: Corner is located in a East-West field line. A crooked field line extends South, beginning about 400' South of corner monument.

FIRM: Wells Surveying

P. O. Box 1696
Pendleton, OR 97801

Surveyor's Seal

IAN33G-5

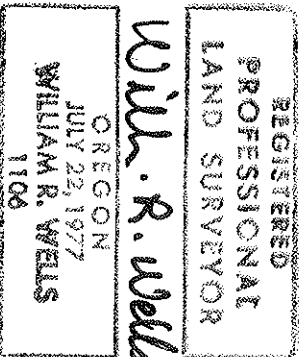

renews 6-30-20

RECEIVED BY

Umatilla County Surveyor

Date: 10/11/2018

Rec'd By: TMA

NO.: 18-087-R