

OREGON CORNER RESTORATION FORM

COUNTY: Umatilla. DATE: 10/05/18.

CORNER DESIGNATION: J-3, The North 1/4 corner of Section 18, Township 4 North, Range 33 East, W.M.

PREVIOUS RENEWAL/SURVEYS ETC: Corner was originally established by Odell and Lewis, Deputy Surveyors, under Contract No. 110, dated February 7, 1865. Notes state:

Set 1/4 Sec. post. Drove charred stake. Dug pits and raised mound as per instructions.

MONUMENT AND ACCESSORIES FOUND: None. Reestablished corner point at old fence and field lines extending South and East.

MONUMENT MARKING DETAIL:

T4N R33E
S7
1/4 -----
S18
2018
PLS 1106

MONUMENT SET: Set a 2 3/8" brass cap on 1 1/4" galvanized iron pipe 30" in the ground. Cap marked as shown in Monument Marking Detail.

New accessories:

- A 5/8" by 24" rebar with red plastic cap bears S 85 1/2° E, 52.7'.
- A 5/8" by 24" rebar with red plastic cap bears N 03° E, 16.1'.
- A 5/8" by 24" rebar with red plastic cap bears S 10° E, 25.5'.
- A 5/8" by 24" rebar with red plastic cap bears S 01° E, 57.0'.


Red plastic caps are marked "ORPLS 1106 W/APLS 17372". All rebar accessories have "bearing object" signs wired to them.

Set steel fence post 1 1/2' North of corner and attached "Witness" sign.

LOCATION AND COMMENTS: Corner is located at the intersection of old fence and field lines extending East and South.

FIRM: Wells Surveying
P.O. Box 1696
Pendleton, OR 97801

Surveyor's Seal

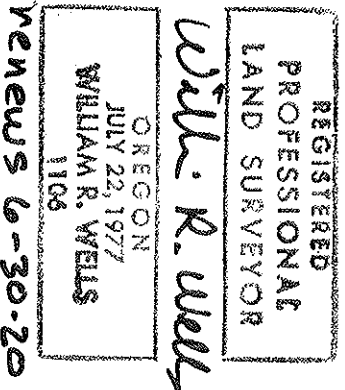

4N33J-3

RECEIVED BY
Umatilla County Surveyor
Date: 10/11/2018
Rec'd By: TMA
NO.: 18-087-R

NEWS 6-30-20