

OREGON CORNER RESTORATION FORM

COUNTY: Umatilla. DATE: 10/05/18.

CORNER DESIGNATION: L-3, The Center 1/4 corner of Section 18, Township 4 North, Range 33 East, W.M.

PREVIOUS RENEWALS/SURVEYS ETC: None.

MONUMENT AND ACCESSORIES FOUND: None. Corner is established by this survey.

MONUMENT MARKING DETAIL:

1/4  
C-----C  
PLS 1106

MONUMENT SET: At the computed corner point, set a 2" aluminum cap on 5/8 by 24" rebar 24" in the ground in a bank in and East-West field line.

New accessories:

- A 5/8" by 24" rebar with red plastic cap bears S 89° E, 39.8'.
- A 5/8" by 24" rebar with red plastic cap bears S 86° E, 22.0'.
- A 5/8" by 24" rebar with red plastic cap bears S 81° W, 13.3'.
- A 5/8" by 24" rebar with red plastic cap bears S 83 1/2° W, 28.0'.

Red plastic caps are marked "ORPLS 1106 W/APLS 17372". All rebar accessories have "bearing object" signs wired to them. Set steel fence post 1.5' South of corner and attached Witness" sign.


LOCATION AND COMMENTS: Corner is located in the bank of an East-West field line. A fence corner, with old fence extending North is located 30' West of corner.

FIRM: Wells Surveying

Surveyor's Seal

P.O. Box 1696  
Pendleton, OR 97801

IAN33L-3

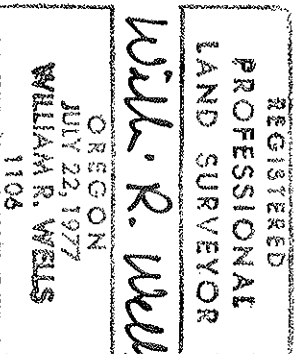

*William R. Wells*

*Renews 6-30-20*

RECEIVED BY

Umatilla County Surveyor  
Date: 10/11/2018  
Recd By: TMA  
No.: 18-087-R