


CERTIFIED RECORD OF LAND CORNER MONUMENTATION

DIAGRAM

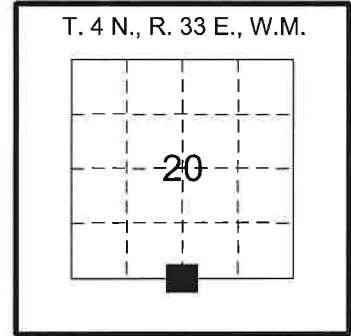

HISTORY OF ORIGINAL CORNER ESTABLISHMENT:

THIS CORNER WAS ORIGINALLY ESTABLISHED BY GENERAL LAND OFFICE SURVEYORS ODELL & LEWIS UNDER CONTRACT NO. 110 DATED FEBRUARY 7, 1865.

SURVEYOR GENERAL LAND OFFICE FIELD NOTES STATE:
 "SET 1/4 SEC. POST, DUG PITS, DROVE CHARRED STAKE,
 & RAISED MOUNDS PER INSTRUCTIONS"

DESCRIPTION OF CORNER EVIDENCE FOUND:

NO ORIGINAL EVIDENCE OF THE MONUMENT OR ITS ACCESSORIES WAS FOUND.

THE BEST REMAINING EVIDENCE OF THE CORNER LOCATION IS THE PHYSICAL INTERSECTION OF ATHENA - HOLDMAN HIGHWAY AND MYRICK ROAD. COUNTY ROAD NOTES FOR MYRICK ROAD (C.R. 975) STATE THAT SAID ROAD WAS BUILT ON THE CENTER OF SECTION LINE OF SECTION 20. THE OREGON STATE HIGHWAY DRAWING 6B-16-17 FOR ATHENA - HOLDMAN SHOWS THE HIGHWAY CENTERED ON THE SECTION LINE BETWEEN SECTIONS 20 & 29.

DESCRIPTION OF MONUMENT AND ACCESSORIES I ESTABLISHED TO PERPETUATE THE ORIGINAL LOCATION OF THIS CORNER:

ESTABLISHED THE CORNER AS SHOWN ON THE RECORD OF SURVEY FOR THE MYRICK STOCKPILE BOUNDARY SURVEY FILED CONCURRENTLY WITH THIS CORNER MONUMENTATION RECORD.

SET 3-1/4" ALUMINUM CAP ON A 5/8" X 30" IRON ROD IN MONUMENT BOX.

THE CAP IS MARKED AS SHOWN BELOW.

THE REFERENCES SET FOR SAID CORNER ARE AS FOLLOWS:

- 1) A 5/8" X 18" IRON ROD WITH A 1-1/2" ALUMINUM CAP STAMPED "ODOT" BEARS N30°08'11"W, 45.54 FEET.
- 2) A 5/8" X 30" IRON ROD WITH A 1-1/2" ALUMINUM CAP STAMPED "ODOT" BEARS N33°08'11"E, 36.33 FEET.
- 3) A 3" BRASS CAP IN CONC. MARKED "OREGON STATE HIGHWAY DEPARTMENT" BEARS S39°26'54"E, 37.16 FEET.
- 4) A 5/8" X 30" IRON ROD WITH A 1-1/2" ALUMINUM CAP STAMPED "ODOT" BEARS S68°19'59"W, 77.84 FEET.



REGISTERED
 PROFESSIONAL
 LAND SURVEYOR

BE

OREGON
 JAN 14, 2003
 BRET N. ELITHORP
 61348

EXPIRES: 12/31/2021

WITNESSES:

BRENT REYNOLDS, TRAVIS COFFELT

I HEREBY CERTIFY THAT THE ABOVE CORNER POSITION WAS RE-ESTABLISHED AS HEREON DESCRIBED ON APRIL 22, 2021.



OREGON DEPARTMENT
 OF TRANSPORTATION
 REGION 5
 SURVEY
 UNIT

| | | | |
|---------|------------------------|-------|-------------|
| Section | MYRICK STOCKPILE | | |
| Highway | ATHENA HOLDMAN HIGHWAY | | |
| County | UMATILLA | Scale | NTS |
| Purpose | BOUNDARY SURVEY | Date | MAY 5, 2021 |

21-059-6