


**CERTIFIED RECORD OF LAND CORNER MONUMENTATION**

**DIAGRAM**

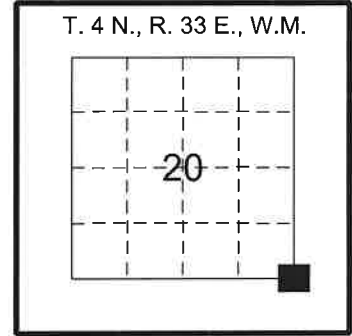

R-9

**HISTORY OF ORIGINAL CORNER ESTABLISHMENT:**

THIS CORNER WAS ORIGINALLY ESTABLISHED BY GENERAL LAND OFFICE SURVEYORS ODELL & LEWIS UNDER CONTRACT NO. 110 DATED FEBRUARY 7, 1865.

SURVEYOR GENERAL LAND OFFICE FIELD NOTES STATE:  
 "SET POST CORNER FOR SECTIONS 20, 21, 28, & 29,  
 DROVE CHARRED STAKE, DUG PITS & RAISED MOUNDS  
 AS PER INSTRUCTIONS"

**DESCRIPTION OF CORNER EVIDENCE FOUND:**

NO ORIGINAL EVIDENCE OF THE MONUMENT OR ITS ACCESSORIES WAS FOUND.

THE BEST REMAINING EVIDENCE OF THE CORNER LOCATION IS THE PHYSICAL LOCATION OF ATHENA - HOLDMAN HIGHWAY AND EXISTING OCCUPATION LINES.

**DESCRIPTION OF MONUMENT AND ACCESSORIES I ESTABLISHED TO PERPETUATE THE ORIGINAL LOCATION OF THIS CORNER:**


ESTABLISHED THE CORNER AS SHOWN ON THE RECORD OF SURVEY FOR THE MYRICK STOCKPILE BOUNDARY SURVEY FILED CONCURRENTLY WITH THIS CORNER MONUMENTATION RECORD.

SET 3-1/4" ALUMINUM CAP ON A 5/8" X 30" IRON ROD IN MONUMENT BOX.

THE CAP IS MARKED AS SHOWN BELOW.

THE REFERENCES SET FOR SAID CORNER ARE AS FOLLOWS:

- 1) A 5/8" X 18" IRON ROD WITH A 1-1/2" ALUMINUM CAP STAMPED "ODOT" BEARS N21°10'21"W, 22.50 FEET.
- 2) A 5/8" X 18" IRON ROD WITH A 1-1/2" ALUMINUM CAP STAMPED "ODOT" BEARS N34°49'52"E, 28.59 FEET.
- 3) A 5/8" X 30" IRON ROD WITH A 1-1/2" ALUMINUM CAP STAMPED "ODOT" BEARS S48°56'47"E, 25.70 FEET.
- 4) A 5/8" X 30" IRON ROD WITH A 1-1/2" ALUMINUM CAP STAMPED "ODOT" BEARS S37°14'24"W, 22.36 FEET.

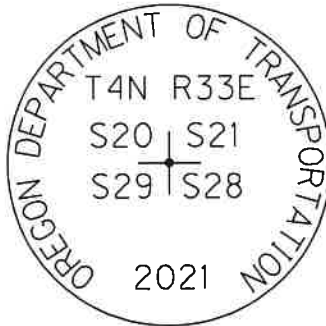

WITNESSES:  
 BRENT REYNOLDS, TRAVIS COFFELT

REGISTERED  
 PROFESSIONAL  
 LAND SURVEYOR

*BE*

OREGON  
 JAN 14, 2003  
 BRET N. ELITHORP  
 61348

I HEREBY CERTIFY THAT THE ABOVE CORNER POSITION WAS RE-ESTABLISHED AS HEREON DESCRIBED ON APRIL 22, 2021.

EXPIRES: 12/31/2021



OREGON DEPARTMENT  
 OF TRANSPORTATION  
 REGION 5  
 SURVEY  
 UNIT

Section	MYRICK STOCKPILE		
Highway	ATHENA HOLDMAN HIGHWAY		
County	UMATILLA	Scale	NTS
Purpose	BOUNDARY SURVEY	Date	MAY 5, 2021

21-059-8