

OREGON CORNER RESTORATION FORM

Section: 2, 3, 34, 35 Township: 3N, 4N Range: 33E
County: Umatilla Date: 3/25/2011

Corner Designation: 3N33A17 (Amended 4/3/2012)

Section corner common to Sections 2, 3, T3NR33E; 34, 35, T4NR33E.

Condition Report Only
 Not Found
 Remonumented
 Unrecorded
 Surveyed In
 Referenced Out


Previous Renewals / Surveys, etc.

Originally surveyed by Thompson in 1864. He set a post in a mound of earth with charred stake, pits, and trench.
In 1976 Krumbain set a 2 1/2" brass cap in Survey M-121-C.
In 1981 Krumbain found a railroad spike in Survey S-153-B.
In 1985 Krumbain recovered a railroad spike and set a 1 1/2" galvanized pipe with a 2 1/2" brass cap, 8" below the surface, in Survey Z17-86-75R.


Monuments and Accessories Found: (Condition and Source):

An unrecorded 2 1/2" brass cap, stamped as shown below, 8" below the surface.

Diagram

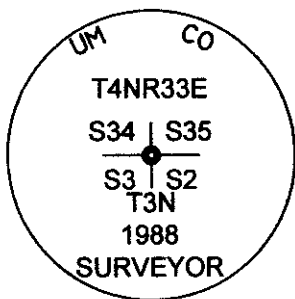

Sketch

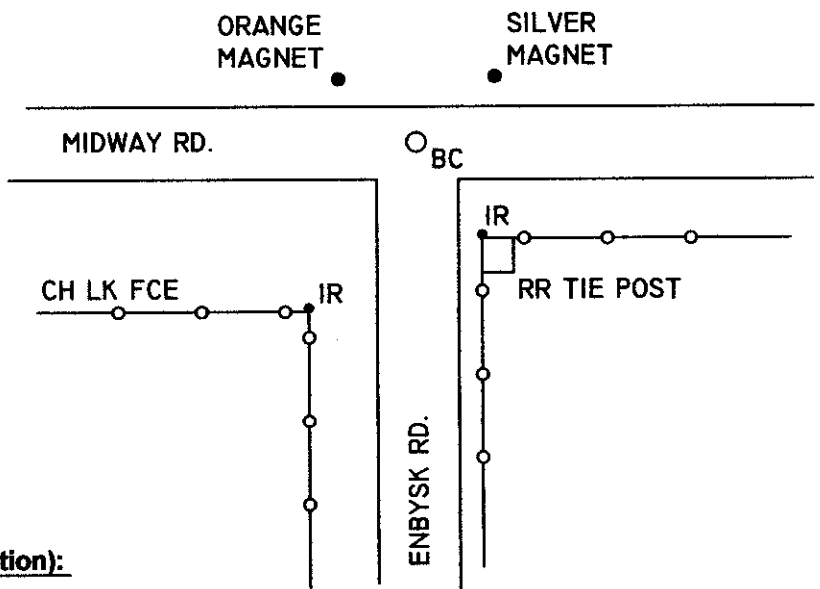

NAD 83/91
OREGON STATE PLANE NORTH
INTERNATIONAL FEET

N774311.42
E8670648.35

Monument(s) Set (Procedures and Description):

None.

References Set:

- "Deep One" magnets by Bermtsen.
- An orange magnet lies N 45° 10' W, 39.74', 1.3' deep.
- A silver magnet lies N 43° 40' E, 37.66', 1.4' deep.
- A 5/8" x 30" iron rebar w/RPC #43406 lies S 37° E, 28.98', at a railroad tie fence corner post.
- A 5/8" x 30" iron rebar w/RPC #43406 lies S 40° 30' W, 75.37', at a chainlink fence corner post.

Location and Comments:

The corner is located at the intersection of Midway Rd. and Enbysk Rd.

Compass Declination

17° E

Surveyors Seal

REGISTERED
PROFESSIONAL
LAND SURVEYOR

Robert D. English
OREGON
JANUARY 11, 2005
ROBERT DOUGLAS ENGLISH
43406LS

RECEIVED BY:

Date: 7/10/2012
Rec'd By: [Signature]
No. 12-094-C

Firm / Agency

Survey One, LLC.
P.O. Box 382
Pendleton, OR 97801
(541) 276-2055

RENEWAL DATE: 12/31/13