

OREGON CORNER RESTORATION FORM

Section 3 Township 3N Range 33E

County Umatilla Date 11-8-85

2-17

CORNER DESIGNATION

- Condition Report Only
- Not Found
- Renewed
- Unrecorded
- Surveyed In
- Referenced Out

Previous Renewals/Surveys, etc. \_\_\_\_\_

Krumbein Engineering Co. 1976, County No. M-2-C; Krumbein 1981 County No. S-153-B


Monument(s) & Accessories Found: (Condition and Source)

Found railroad spike as per No. S-153-B at the "T" intersection of a county road and a North running plow line

Monument Detail



Sketch

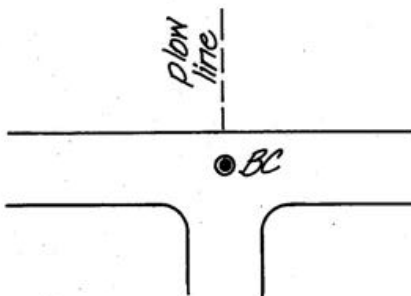

Monument Set (Procedures and Description)

2 1/2" Brass Cap on 1 1/2" galvanized pipe set at position of railroad spike and burried 8" below surface

New Accessories

Location & Comments

Surveyor's Seal

RECEIVED BY  
 Umatilla County Surveyor  
 Date 6-26-86  
 Rec'd By AA  
 No. 86-75-R

Compass Declination \_\_\_\_\_  
 Firm/Agency Krumbein Engineering Ltd.  
 Address 361 S.E. Second Pendleton, Oregon 97801  
 Party Chief R. Panches  
 Notes \_\_\_\_\_  
 Witness S. Carlson

