

**OREGON CORNER RESTORATION FORM**

Section 6,31 Township 3N,4N  
County Umatilla Date: 03/15/11

Range 33E

Corner Designation: 3N33A3

Condition Report Only  
 Not Found  
 Remonumented  
 Unrecorded  
 Surveyed In  
 Referenced Out


**Previous Renewals / Surveys, etc.**

Originally Surveyed by Thompson in 1864. He set a post in a mound of earth.


**Monuments and Accessories Found: (Condition and Source)**

None.

Diagram

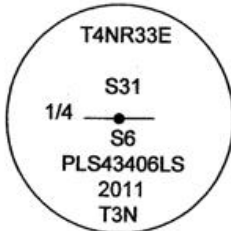

Sketch

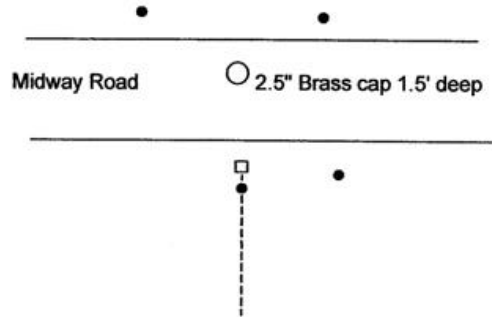

NAD 83/91  
OREGON STATE PLANE NORTH  
INTERNATIONAL FEET

N773914.08  
E8652189.63

**Monument (s) Set (Procedures and Description)**

A 1 1/8" X 30" galvanized iron pipe with a 2 1/2" Brass cap, 18" below surface of road, stamped as shown above. There is a railroad tie post at the end of the field lines which is apparently been held as the property line. I hold this post for Easting and the East-West line between two found monuments for Northing, as best evidence of the original corner position.

**References Set: "Deep One" magnets by Berntsen.**

A Silver magnet, 19" deep, lies N 41°20' E, 22.71'.  
A Pink magnet, 20" deep, lies S 28° E, 45.20'.  
An Azimuth mark lies South, 34.09'.  
An Orange magnet, 20" deep, lies N 30°40' W, 21.56'.

**Location and Comments**

The corner is 0.5 miles East of the intersection of McCormmach Road and Midway Road.

**Compass Declination**

17° E

**Surveyors Seal**

REGISTERED  
PROFESSIONAL  
LAND SURVEYOR

*Robert D. English*

OREGON  
JANUARY 11, 2005  
ROBERT DOUGLAS ENGLISH  
43406LS

**RECEIVED BY:**

Date: \_\_\_\_\_  
Rec'd By: \_\_\_\_\_  
No. \_\_\_\_\_

**Firm / Agency**

Survey One, LLC.  
P.O. Box 382  
Pendleton, OR 97801  
(541) 276-2055

RENEWAL DATE: 12/31/11