

**OREGON CORNER REFORMATION FORM**

Section 14 Township 4N Range 36E  
 County Umatilla Date: October 28, 2005

Corner Designation: 4N36J17

Corner to sections 10, 11, 14 and 15, T4N, R36E, W.M.,  
 Umatilla County, Oregon.


Condition Report Only  
 Not found  
 Remonumented  
 Unrecorded  
 Surveyed in  
 Referenced out

Previous Renewals / Surveys, etc.

Corner originally set by William H. Odell under contract No. 114 dated July 2, 1866. His record reads: Set post Cor for Secs. 10, 11, 14 & 15; drove charred stake and raised mound as per instructions.

Monument and Accessories found: ( condition and source )

I found a stone mound with the remains of the burnt wooden stake. The mound agrees with the original calls north and east to the old road groove and also with the projection of a fence line from the north.

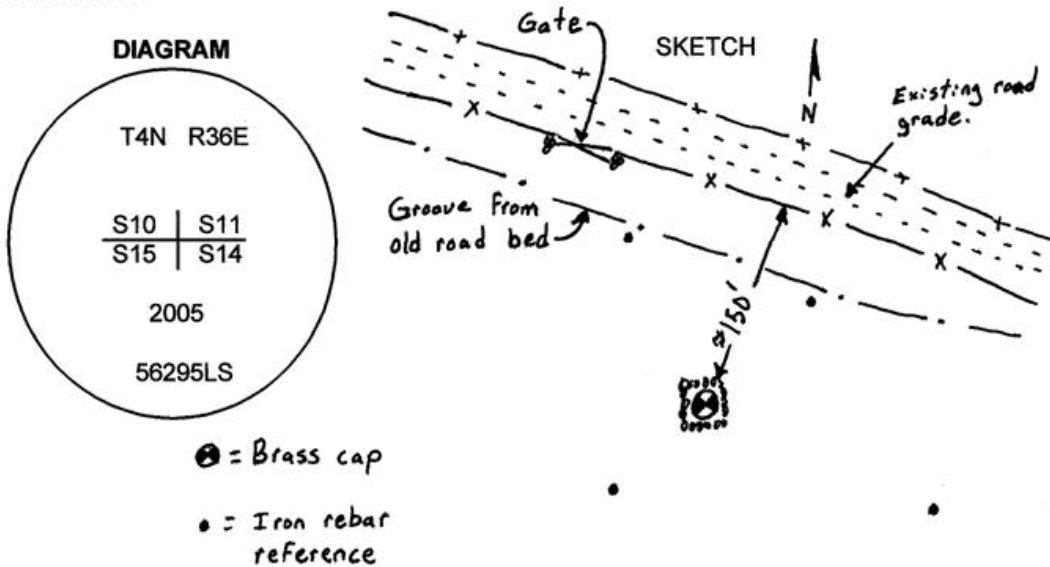

**MONUMENT (S) AND ACCESSORIES SET (Procedures and Description)**

At the position of the charred stake I set a 1 1/2" x 30" galvanized iron pipe with a 2 1/4" brass cap attached stamped as shown in the diagram above 20" in the ground to bedrock. I built a mound of stone and dirt 36" diameter to the top of the cap.

For references, I set four, 5/8" by 24" rebars with 1 1/8" orange plastic caps attached, stamped WTS and 56295LS as described below:

- an iron rebar bears N14°48'18"W, 57.42 feet;
- an iron rebar bears N50°10'11"E, 78.39 feet;
- an iron rebar bears S47°10'27"E, 136.32 feet;
- an iron rebar bears S48°48'27"W, 58.02 feet;

The monument and references were tied using a Trimble R7/R8 RTK GPS.


Location and comments

Compass Declination


Surveyors Seal

RECEIVED BY:  
Umatilla County Surveyor  
 Date: 11-05  
 Rec'd By: KK  
 No. 05-198-C

Firm / Agency  
 Witness Tree Surveying  
 Address  
 P.O. Box G  
 Pilot Rock, Or. 97868  
 Party Chief  
 Stephen K, Haddock

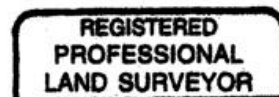

*Stephen K. Haddock*

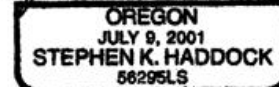

RENEWAL DATE 6-30-07