

OREGON CORNER RESTORATION FORM

Section 14 Township 4N Range 36E
 County Umatilla Date: November 4, 2005

Corner Designation: 4N36L19

Condition Report Only

Center 1/4 corner to Section 14, T4N, R36E W.M.
 Umatilla County, Oregon.

Not found
 Remonumented
 Unrecorded
 Surveyed in
 Referenced out


Previous Renewals / Surveys, etc.

There has been no previous establishment of a monument at this corner point.

Monument and Accessories found: (condition and source)

None.

DIAGRAM

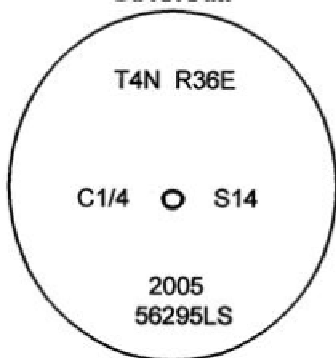

SKETCH

MONUMENT (S) AND ACCESSORIES SET (Procedures and Description)

I set a 1" x 24" iron rebar with a 2" aluminum Cap stamped as shown above flush with the surface of the ground at the calculated center 1/4 location.

For references, I set four 5/8" by 24" iron rebars with 1 1/8" orange plastic caps stamped WTS and 56295LS as described below:

- a rebar bears N41°59'33"W, 54.67 feet;
- a rebar bears N67°48'05"E, 30.86 feet;
- a rebar bears S32°25'34"E, 30.90 feet;
- a rebar bears S72°35'58"W, 21.28 feet;

The monument was set and references tied using a Trimble R7/R8 RTK GPS.

Location and comments

Compass Declination

Surveyors Seal

RECEIVED BY:
Umatilla County Surveyor
 Date: 11-05
 Rec'd By: KK
 No. 05-198-C

Firm / Agency
 Witness Tree Surveying
 Address
 P.O. Box G
 Pilot Rock, Or. 97868
 Party Chief
 Stephen K, Haddock

REGISTERED
 PROFESSIONAL
 LAND SURVEYOR

Stephen K. Haddock

OREGON
 JULY 9, 2001
 STEPHEN K. HADDOCK
 56295LS

RENEWAL DATE 6-30-07