

OREGON CORNER RESTORATION FORM

COUNTY: Umatilla. DATE: 10/17/19.

CORNER DESIGNATION: P-9, The West 1/4 corner of Section 21, Township 4 North, Range 36 East, W.M.

PREVIOUS RENEWALS/SURVEYS ETC: Corner was originally established by William H. Odell, Deputy Surveyor, under Contract No. 114, dated July 2, 1866. Notes state: Set post Cor. For 1/4 Sec., in prairie: drove charred stake, dug pits and raised mound as per instructions.

MONUMENT AND ACCESSORIES FOUND: None. Accepted projected intersection from old fences extending East and South and as best remaining evidence of the corner point.

MONUMENT MARKING DETAIL:

T4N R36E	NAD 83 (2011) epoch 2010.00 Coordinates
1/4	International feet units:
S20 S21	N: 788441.80
2019	E: 8753746.42
PLS 1106	

MONUMENT SET: A projected intersection of fences extending East and South, set a 5/8 by 24" rebar with 2" aluminum cap 24" in the ground. Cap is marked as shown in "Monument Marking Detail".

New accessories:

- A 5/8 by 24" rebar with 1 1/4" red plastic cap bears S 87° E, 20.9', set in fence angle point.
- A 5/8 by 24" rebar with 1 1/4" red plastic cap bears South, 19.2', set in fence angle point.
- A 10" Ponderosa Pine bears S 53° E, 48.6' scribed 1/4 S21 BT.
- A 12" Ponderosa Pine bears S 24° E, 63.3', scribed 1/4 S21 BT.


Red plastic caps are marked "ORPLS 1106 WAPLS 17372". Rebar accessories have "bearing object" signs wired to them. Bearing trees have Bearing Tree signs nailed to them.

Nailed a "Witness" sign to railroad tie fence corner angle point South of corner.

LOCATION AND COMMENTS: Corner is located on a ridge top at a projected fence intersection with fences East and South. Used Spencer tape and compass with 14° East declination to measure to corner accessories.

FIRM: Wells Surveying
P.O. Box 1696
Pendleton, OR 97801

Surveyor's Seal

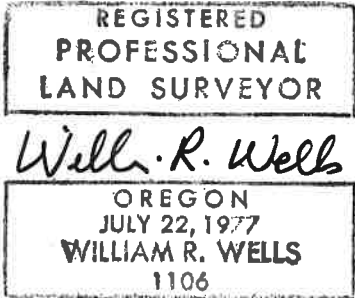

renews 6-30-20

4N36P-9

20-023-R