

**OREGON CORNER RESTORATION FORM**

COUNTY: Umatilla. DATE: 10/11/19.

CORNER DESIGNATION: R-13, The Northeast corner of Section 28, Township 4 North, Range 36 East, W.M.

PREVIOUS RENEWALS/SURVEYS ETC: Corner was originally established by William H. Odell, Deputy Surveyor, under Contract No. 114, dated July 2, 1866. Notes state:

Set post Cor. For Secs. 21, 22, 27 & 28, from which:

A Pine, 36 ins. diam. brs. S 20° E., 60 lks.

A Pine, 30 ins. diam. brs. S 68° W., 139 lks.

A Pine, 24 ins. diam. brs. N 30° W., 129 lks.

A Pine, 4 ins. diam. brs. N 55° E., 17 lks.

In April, 1885, W.T. Chalk, County Surveyor, recovers the old government stake lying on the ground, much decayed, and sets a basalt stone, 16 1/2 X 5 X 4" 18 " in the ground at the corner point. Chalks survey began at this corner and extended North.

MONUMENT AND ACCESSORIES FOUND: None. Accepted fence corner intersection and as best remaining evidence of the corner point. The fence corner was shown to me by Tom Buell, property owner. I probed and dug around the fence corner, searching for Chalk's stone, without results. There are no remaining trees which could have been original bearing trees.

MONUMENT MARKING DETAIL:

T4N R36E  
S21 | S22  
-----  
S28 | S27  
2019  
PLS 1106

NAD 83 (2011) epoch 2010.00 Coordinates  
International feet units:  
N: 785946.26  
E: 8759185.98

MONUMENT SET: Set a 5/8 by 24" rebar with 2" aluminum cap 24" in the ground at fence corner intersection. Cap is marked as shown in "Monument Marking Detail". The monument is set just West of a fence intersection post with fences extending Northerly, Easterly and Southerly. There is a round sawn off post, (possibly and old power pole), just West of the corner monument.

New accessories:

A 5/8 by 24" rebar with 1 1/4" red plastic cap bears N 86°53' E, 49.56', set in fence line.

A 5/8 by 24" rebar with 1 1/4" red plastic cap bears N 11°32' W, 46.67', set in fence line to gate.

A 28" Ponderosa Pine bears S 44° E, 23.9' with 3/4" brass washer marked "PLS 1106" nailed to Northerly side center of tree, 1.5 feet above ground line. No sign.

A 28" bushy Ponderosa Pine bears N 62° W, 12.2' with 3/4" brass washer marked "PLS 1106" nailed to Southerly side center of tree 1.5 feet above ground line. Bearing Tree sign nailed to tree, facing corner.


Red plastic caps are marked "ORPLS 1106 WAPLS 17372". Rebar accessories have "bearing object" signs wired to them.

Nailed a "Witness" sign to fence corner post just East of corner monument.


LOCATION AND COMMENTS: Corner is located on an East slope at a fence corner at the NW corner of a cattle feeding pasture. Used spencer tape and compass with 18° East declination to measure tree corner accessories.

FIRM: Wells Surveying  
P.O. Box 1696  
Pendleton, OR 97801

Surveyor's Seal

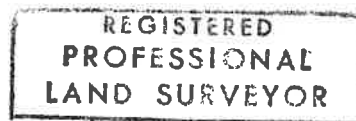

*William R. Wells*

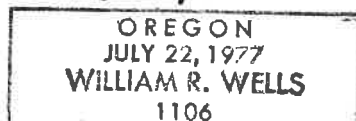

*renews 6-30-20*

4N36R-13

*20-026-R*