

OREGON CORNER RESTORATION FORM

COUNTY: Umatilla. DATE: 10/17/19.

CORNER DESIGNATION: R-9, The Northwest corner of Section 28, Township 4 North, Range 36 East, W.M.

PREVIOUS RENEWALS/SURVEYS ETC: Corner was originally established by William H. Odell, Deputy Surveyor, under Contract No. 114, dated July 2, 1866. Notes state:
Set post Cor. For Secs. 20, 21, 28 & 29, from which:
A Pine, 12 ins. diam. brs. S 5° W., 36 lks.
A Pine, 15 ins. diam. brs. S 30° E., 63 lks.

MONUMENT AND ACCESSORIES FOUND: None. Reestablished corner point at mid-way latitude between the West 1/4 corners of Sections 21 and 28, holding old North-South fence line for departure.

MONUMENT MARKING DETAIL:

T4N R36E	NAD 83 (2011) epoch 2010.00 Coordinates
S20 S21	International feet units:
-----	N: 785801.86
S29 S28	E: 8753871.39
2019	
PLS 1106	

MONUMENT SET: At the reestablished corner point, set a 5/8 by 24" rebar with 2" aluminum cap 23" in the ground. Cap is marked as shown in "Monument Marking Detail". The monument is set in a North-South fence line just East of an eroded "ditch", located West of and paralleling the fence line.

New accessories:
A 10" Ponderosa Pine bears N 38° E, 53.2' scribed T4N R36E S21 BT.
A 9" Ponderosa Pine bears East, 37.6' scribed T4N R36E S21 BT.
A 10" Ponderosa Pine bears S 44° E, 37.0' scribed T4N R36E S28 BT.
A 5" Ponderosa Pine bears S 21° E, 57.1' scribed X at breast height and BT at base of tree.


Attached bearing tree signs to the new bearing trees.

Nailed a "witness" sign to railroad tie in North-South fence 11 feet South of the corner monument.


LOCATION AND COMMENTS: Corner is located on a South facing slope about 200 feet north of a dirt road, (Pea Ridge County Road). Used Spencer tape and compass with 14° East declination to measure bearing tree corner accessories.

FIRM: Wells Surveying
P.O. Box 1696
Pendleton, OR 97801

Surveyor's Seal

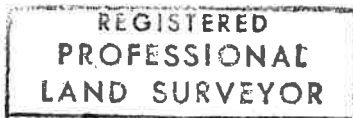

Willh. R. Wells

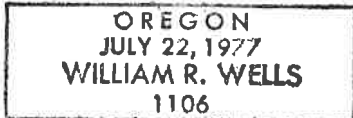

renews 6-30-20

4N36R-9

20-024-R