

OREGON CORNER RESTORATION FORM

COUNTY: Umatilla. DATE: 10/18/19.

CORNER DESIGNATION: T-11, The Center 1/4 corner of Section 28, Township 4 North, Range 36 East, W.M.

PREVIOUS RENEWALS/SURVEYS ETC: No record was found for establishment of this corner. Section 28 is an irregular Section because of "stubbing" methods used by original Deputy Surveyor William H. Odell, with South Half of the Section offset Westerly from the North Half. For the Center 1/4 corner of Section 28, I held the ancient North-South fence with projected Westerly intersection of the old fence extending East, to conform with existing possessory lines. The close agreement with existing fence lines and old farmed field berms in the SW 1/4 of Section 28 indicate this corner position has been used in the past for breakdown of the Section 28, but no monuments were recovered.

MONUMENT AND ACCESSORIES FOUND: Held ancient North-South fence with projected Westerly intersection of the old fence extending East, to conform with existing possessory lines, road and building locations.

MONUMENT MARKING DETAIL:

T4N R36E
1/4
C-----C
S28
2019
PLS 1106

NAD 83 (2011) epoch 2010.00 Coordinates
International feet units:
N: 783252.75
E: 8756517.61

MONUMENT SET: At held corner point, set a 5/8 by 24" rebar with 2" aluminum cap 22" in the ground. Cap is marked as shown in "Monument Marking Detail".

New accessories:

- A 3/4" brass washer nailed to the West side of UECA power pole no. 284400 bears S 14° W, 5.5'.
- A 5/8 by 24" rebar with 1 1/4" red plastic cap set on West side of North-South fence bears S 08°34' W, 27.24'.
- A 5/8 by 24" rebar with 1 1/4 red plastic cap, on West side of North-South fence bears N 01°22' E, 26.56'.
- A 5/8 by 24" rebar with 1 1/4 red plastic cap, on West side of North-South fence bears N 01°43' E, 53.79'.


Red plastic caps are marked "ORPLS 1106 WAPLS 17372". Rebar accessories have "bearing tree" signs wired to them because "bearing object" signs were not available. Measurements to rebar accessories were made with total station. Used Spencer tape and compass with 14° East declination to measure to brass washer in power pole.

Nailed a "Witness" sign to 2 by 4 fence stay just South of corner monument.


LOCATION AND COMMENTS: Corner is located on a South facing slope, West of a North-South fence and West of a lane (road).

FIRM: Wells Surveying
P.O. Box 1696
Pendleton, OR 97801

Surveyor's Seal

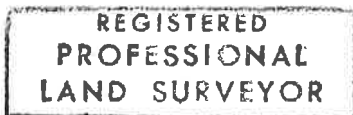

William R. Wells

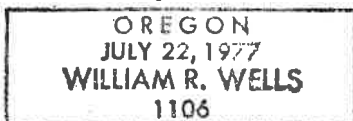

renews 6-30-20

\4N36T-11

20-028-R